

PERRY

MISSISSIPPI BOARD OF WATER COMMISSIONERS

N5

S. & G. Drilling
WATER WELL DRILLERS LOG

5-16-66

Date: 5/16, 1966, Driller: Gene

County: Forest

(Name)

- (1) Owner of Land: P. V. Martin
(Name)
Brooklyn Miss #1
(Address)
- (2) Location: NW 1/4, SW 1/4, Sec. 8 T. 1 R. 11 W.
5 miles E of Brooklyn
(distance) (direction) (Nearest Town)
- (3) Topography: Hilly
(Hilly) (Flat) (Level)
- (4) Purpose of Well: Home
(Domestic Irrigation
Municipal, Industrial, Other)

Description & Color of Materials Sand, Clay, Red Clay, Shell, etc.	Thick- ness Feet	Depth Feet
<u>Red Sandy Clay</u>	<u>18</u>	<u>18</u>
<u>white + Blue Clay</u>	<u>30</u>	<u>48</u>
<u>blue Sand (fine)</u>	<u>16</u>	<u>64</u>
<u>white Sand + Clay</u>	<u>22</u>	<u>86</u>
<u>good Sand</u>	<u>19</u>	<u>105</u>


Information upon completion of well:

- (1) Diameter 4 inches.
- (2) Total Depth 105 feet.
- (3) Water Level 65 feet below top of ground.
- (4) Cased to 95 ft, Size 4"
- (5) Screen: Size 4", Length 10 ft
- (6) Were any formations sealed against pollution?
no

If YES depth of formation _____

Why _____

Drillers Remarks: Jet pump 1 HP

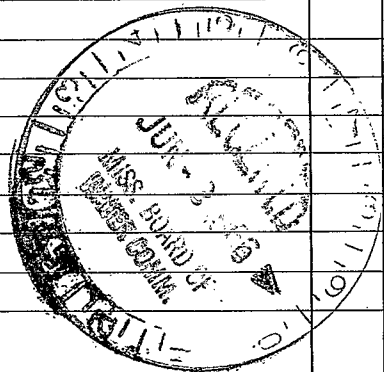

(Use Back Side)

Well No. 20

