

Perry
 N 10
 3-30-68

MISSISSIPPI
 BOARD OF WATER COMMISSIONERS
 416 North State Street
 Jackson, Mississippi 39201

CODED
 CODED

WATER WELL DRILLERS LOG

3-30 1968
 date well completed

Low Smith
 firm name

Perry
 county well located

LANDOWNER:

David Whalley

description of formations encountered

Top Soil
Clay
Sand
Clay

from to

0 1
 1 20
 20 70

(mailing address)

WELL LOCATION:

sec. 11 T. 1 N R. 11 W
4 miles W of Jones
 (distance) (direction) (nearest town)

WELL PURPOSE:

(home, irrigation, municipal, industrial)

WELL COMPLETION DATA:

- (1) diameter (inches) 2
 (2) total depth (feet) 70
 (3) static water level (feet) 62 below above top of ground.
 (4) casing Plaste 10'
 (material) (depth)

_____ if telescope see back.
 (size)

- (5) screen 5' 65
 (length) (depth to top)

_____ (size) _____ (material)

- (6) pump 1 6
 (HP) (yield gpm)

Electric
 (type power)

- (7) electric log _____
 (yes or no)

_____ (organization running log)

- (8) how well bottom plugged. back


DRILLERS REMARKS:

FEB - 4 1968

MISS. BD. OF
 WATER COMM.

If well telescopes please sketch and show depths.

GROUND LEVEL

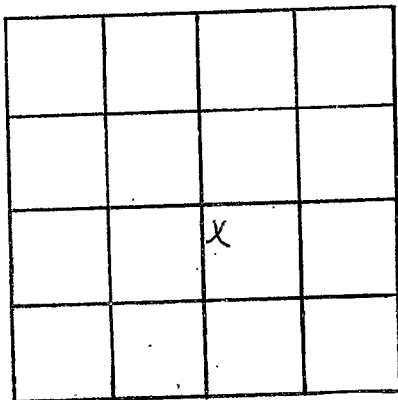

SECTION 11

Please indicate well location X.

ADDITIONAL INFORMATION

If more than one screen, show locations of each on sketch.