

PERRY
 N13
 5-18-70

MISSISSIPPI
 BOARD OF WATER COMMISSIONERS
 416 North State Street
 Jackson, Mississippi 39201

CODED

WATER WELL DRILLERS LOG

5-18 1970 L W Smith Perry
 date well completed firm name county well located

LANDOWNER:
 Janice Baptist Church
 (mailing address)

description of formations encountered	from	to
Top S.	0	2
Sandy clay	2	20
Sand & Gravel	20	52

WELL LOCATION:
 sec. 30 T. 1 N R. 11 W
 (distance) miles (direction) of (nearest town)

WELL PURPOSE:
 (home, irrigation, municipal, industrial)

WELL COMPLETION DATA:

(1) diameter (inches) 2"

(2) total depth (feet) 52'

(3) static water level (feet) 35 below above top of ground.

(4) casing Plastic (material) (depth) (size) if telescope see back.

(5) screen 5' (length) 47' (depth to top) (size) (material)

(6) pump 1/2 (HP) 8 (yield gpm) (type power)

(7) electric log (yes or no) (organization running log)

(8) how well bottom plugged Cap.

CODED


AUG 6 1970

DRILLERS REMARKS:

MISS. Bd. OF WATER COMMISSIONERS

If well telescopes please sketch and show depths.

GROUND LEVEL

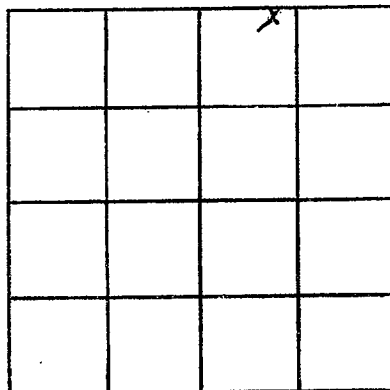

SECTION _____

Please indicate well location X.

ADDITIONAL INFORMATION

If more than one screen, show locations of each on sketch.