

PERRY
N 15
10-2-70

MISSISSIPPI
 BOARD OF WATER COMMISSIONERS
 416 North State Street
 Jackson, Mississippi 39201

WATER WELL DRILLERS LOG

CODED

10-2 1970 Parnell Anderson Perry
 date well completed firm name county well located

LANDOWNER: James Miller
 Rt 1 Box 130
 Brooklyn
 (mailing address)

WELL LOCATION:
 sec. 36 T 1 N R 11 E W
 12 miles W of Brooklyn
 (distance) (direction) (nearest town)

WELL PURPOSE:
 (home, irrigation, municipal, industrial)

- WELL COMPLETION DATA:
- (1) diameter (inches) 2
 - (2) total depth (feet) 357
 - (3) static water level (feet) 28 below top of ground
 - (4) casing Plastic, 352
 (material) (depth)
 (size) if telescope see back.
 - (5) screen 5, 352
 (length) (depth to top)
2", Plastic
 (size) (material)
 - (6) pump 1, 11
 (HP) (yield gpm)
Elect
 (type power)
 - (7) electric log (yes or no) _____
 (organization running log) _____
 - (8) how well bottom plugged Backwash Valve

description of formations encountered	from	to
Top Soil	0	3
Red Clay	3	16
Fine Sand	16	24
White Clay	24	40
Blue Clay	40	189
Fine Sand	189	214
Blue Clay	214	310
Fine Sand	310	338
Coarse Sand	338	357

CODED


JUN 11 1971

MISS. Bd. OF
 WATER COMMISSIONERS

DRILLERS REMARKS:

If well telescopes please sketch and show depths.

GROUND LEVEL

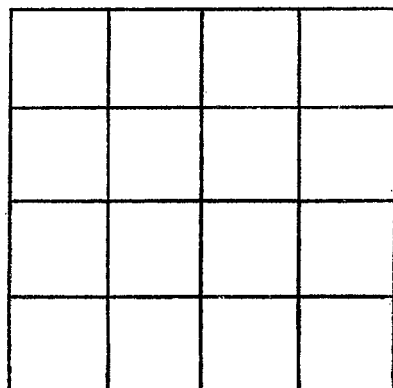

SECTION _____

Please indicate well location X.

ADDITIONAL INFORMATION

If more than one screen,
show locations of each on sketch.