

PERRY  
N 16

4-5-72

MISSISSIPPI  
BOARD OF WATER COMMISSIONERS  
416 North State Street  
Jackson, Mississippi 39201

CODED

WATER WELL DRILLERS LOG

11-5  
date well completed

1972 Parnell Anderson  
firm name

Perry  
county well located

LANDOWNER: Larry L. Breland

Brooklyn MISS.

(mailing address)

WELL LOCATION:

sec. 10 T 1 N R 11 W  
8 miles E of Brooklyn  
(distance) (direction) (nearest town)

WELL PURPOSE: Home  
(home, irrigation, municipal, industrial)

WELL COMPLETION DATA:

(1) diameter (inches) 2  
(2) total depth (feet) 156  
(3) static water level (feet) 43 below  
top of ground.

(4) casing Plastic, 151  
(material) (depth)

(size) if telescope see back.

(5) screen 5', 151  
(length) (depth to top)

2", Plastic  
(size) (material)

(6) pump 1 12  
(HP) (yield gpm)

Elect  
(type power)

(7) electric log (yes or no)

(organization running log)

(8) how well bottom plugged  
Backwash Valve

description of formations  
encountered

from to


Top Soil	0	3
Red Clay	3	19
Fine Sand	19	27
Blue Clay	27	138
Fine Sand	138	141
Coarse Sand	141	156

CODED

DRILLERS REMARKS:

If well telescopes please sketch and show depths.

GROUND LEVEL

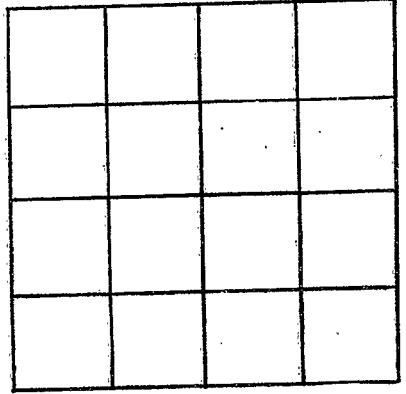

SECTION \_\_\_\_\_

Please indicate well location X.

ADDITIONAL INFORMATION

Lined area for additional information.

If more than one screen, show locations of each on sketch.