

PERRY
N 18
3-19-74

MISSISSIPPI
 BOARD OF WATER COMMISSIONERS
 416 North State Street
 Jackson, Mississippi 39201

WATER WELL DRILLERS LOG

March 19 1974 Cochran Drilling Service Perry
 date well completed firm name county well located

LANDOWNER:

Calvin Clark

(mailing address)

WELL LOCATION:

sec. 12 T. 1 N. S R. 11 E. W

_____ miles _____ of _____
 (distance) (direction) (nearest town)

WELL PURPOSE: home
 (home, irrigation, municipal, industrial)

WELL COMPLETION DATA:

- (1) diameter (inches) 2"
- (2) total depth (feet) 50'
- (3) static water level (feet) 27 (below/above top of ground)
- (4) casing PVC, 45'
 (material) (depth)
2" if telescope see back.
 (size)
- (5) screen 5', 45'
 (length) (depth to top)
2", PVC
 (size) (material)
- (6) pump 1 7
 (HP) (yield gpm)
Elect
 (type power)
- (7) electric log no.
 (yes or no)

 (organization running log)
- (8) how well bottom plugged Value

description of formations encountered

from to


<u>top soil</u>	<u>0</u>	<u>2</u>
<u>red clay</u>	<u>2</u>	<u>7</u>
<u>brown clay</u>	<u>7</u>	<u>12</u>
<u>gray clay</u>	<u>12</u>	<u>23</u>
<u>base</u>	<u>23</u>	<u>50</u>

DRILLERS REMARKS:

RECORDED
 MAY 3 1974
 MISS. BD. OF WATER COMMISSIONERS

If well telescopes please sketch and show depths.

GROUND LEVEL

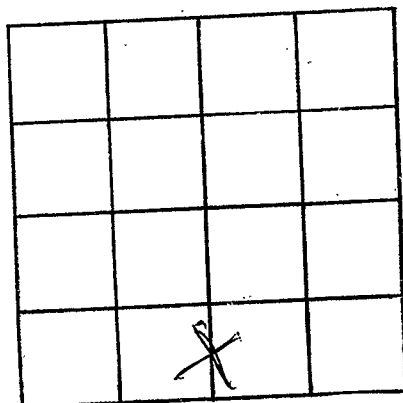

SECTION 12

Please indicate well location X.

ADDITIONAL INFORMATION

If more than one screen, show locations of each on sketch.