

PERRY
N 21
7-22-75

MISSISSIPPI
 BOARD OF WATER COMMISSIONERS CODED
 416 North State Street
 Jackson, Mississippi 39201

WATER WELL DRILLERS LOG

Perry

7-22 date well completed *75* firm name *H. Hill* county well located

LANDOWNER:	description of formations encountered	from	to
<i>H. Hill</i>	<i>clay</i>	<i>0</i>	<i>8'</i>
<i>Brooklyn miss</i> (mailing address)	<i>fine sand</i>	<i>8'</i>	<i>13'</i>
WELL LOCATION: sec <i>5</i> T <i>1</i> N <i>13Q</i> R <i>12</i> E W <i>13Q</i>	<i>stretch 100'</i>	<i>13'</i>	<i>22'</i>
<i>5</i> miles <i>E</i> <i>Brooklyn</i> (distance) (direction) (nearest town)	<i>Dea Travel & Serv</i>	<i>22'</i>	<i>32'</i>

WELL PURPOSE: *Home*
 (home, irrigation, municipal, industrial)


- WELL COMPLETION DATA:
- (1) diameter (inches) *2"*
 - (2) total depth (feet) *32'*
 - (3) static water level (feet) *10'* below above top of ground.
 - (4) casing *Plastic* *2 1/2"* (material) (depth)
2" If telescope see back. (size)
 - (5) screen *2 1/2"* *32'* (length) (depth to top)
2" (size) *Plastic* (material)
 - (6) pump *1/2* *6 gal* (HP) (yield gpm)
900 (type power)
 - (7) electric log (yes or no)
 (organization running log)
 - (8) how well bottom plugged *blue*

DRILLERS REMARKS:

REGISTERED
MAY 28 1975
 MISS. Bd. OF WATER COMMISSIONERS

If well telescopes please sketch and show depths.

GROUND LEVEL

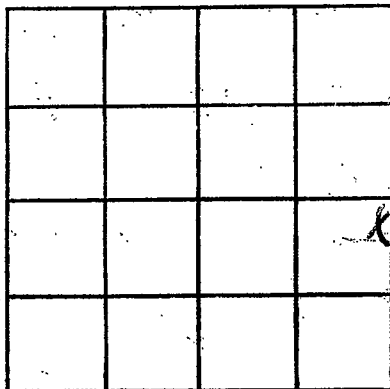

SECTION _____

Please indicate well location X.

ADDITIONAL INFORMATION

If more than one screen, show locations of each on sketch.