

MISSISSIPPI DEPARTMENT OF NATURAL RESOURCES

Bureau of Land and Water Resources

Southport Mall

P.O. Box 10631

Jackson, Mississippi 39209

WATER WELL DRILLERS LOG

CODED

PERRY  
W 23  
5/14/83

Griner Drilling Service, Inc.

Perry

5-14-83 date well completed

Griner Drilling Service, Inc. firm name

Perry county well located

LANDOWNER:

David New Drilling Co  
P.O. Drawer 1487  
Natchez, Ms. 39120

(mailing address)

description of formations encountered

from

to

Sand

0 54

streaked, mostly clay

54 445

WELL LOCATION: 2120'S + 6711'E

sec. 22 T-1 N R-11 E NW/4

SAND

445 504

No. 1 A. 27.5 miles Brooklyn  
Vis. (distance) (direction) (nearest town)

WELL PURPOSE: oil field supply  
(home, irrigation, municipal, industrial)

WELL COMPLETION DATA:

- (1) diameter (inches) 3"
- (2) total depth (feet) 504'
- (3) static water level (feet) 80' below top of ground.

CODED

- (4) casing steel 504' (material) (depth)  
3" (size) if telescope see back.

- (5) screen 42' 462' (length) (depth to top)  
3" perforated (size) (material)

- (6) pump AC 75 (HP) (yield gpm)  
(type power)

- (7) electric log (yes or no)  
(organization running log)

- (8) how well bottom plugged orange peel

DRILLERS REMARKS:


DEPT. OF NATURAL RESOURCES  
BUREAU OF LAND & WATER RESOURCES

MAY 20 1983

RECEIVED

If well telescopes please sketch and show depths.

GROUND LEVEL

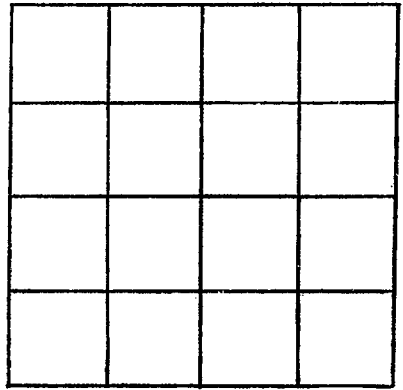

SECTION \_\_\_\_\_

Please indicate well location X.

ADDITIONAL INFORMATION

If more than one screen, show locations of each on sketch.