

Was first Numbered Q 9

CODED

MISSISSIPPI
BOARD OF WATER COMMISSIONERS
416 North State Street
Jackson, Mississippi 39201

Perry
N 2000
6-10-69

WATER WELL DRILLERS LOG

6-10 1969 L. W. Smith Perry
date well completed firm name county well located

LANDOWNER:
Robert Smith

(mailing address)

description of formations encountered	from	to
<u>Top 5'</u>	<u>0</u>	<u>1</u>
<u>Sandy clay</u>	<u>1</u>	<u>30</u>
<u>Hard Clay</u>	<u>30</u>	<u>42</u>

WELL LOCATION:
sec. 12 T. 1 N R. 11 W
miles 4 of Jones
(distance) (direction) (nearest town)

WELL PURPOSE:
(home, irrigation, municipal, industrial)

WELL COMPLETION DATA:

(1) diameter (inches) 2"

(2) total depth (feet) 42'

(3) static water level (feet) 30 below above top of ground.

(4) casing Plastic 37'
(material) (depth)
(size) if telescope see back.

(5) screen 5' 37'
(length) (depth to top)
(size) (material)

(6) pump 1 12
(HP) (yield gpm)
Electric
(type power)

(7) electric log
(yes or no)

(organization running log)

(8) how well bottom plugged B.W.


DRILLERS REMARKS:

JUL 30 1969

MISS. BD. OF
WATER COM.

If well telescopes please sketch and show depths.

GROUND LEVEL

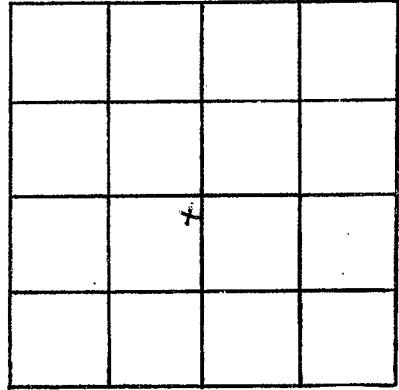

SECTION _____

Please indicate well location X.

ADDITIONAL INFORMATION

If more than one screen, show locations of each on sketch.