

Ferry
N 2003
6-4-80

MISSISSIPPI
 BOARD OF WATER COMMISSIONERS
 416 North State Street
 Jackson, Mississippi 39201

WATER WELL DRILLERS LOG

6-4-80 date well completed Ferry firm name Perry county well located

LANDOWNER: H. Freeman

RI 1, Box 53

New Augusta MS

(mailing address) 39462

WELL LOCATION:

sec. 10 T 1 N 11?
 S 5 R 10 E W

0.10 miles SW of New Augusta
 (distance) (direction) (nearest town)

WELL PURPOSE:

(home, irrigation, municipal, industrial)

WELL COMPLETION DATA: 6:5-80

- (1) diameter (inches) 2"
- (2) total depth (feet) 465
- (3) static water level (feet) 4' below top of ground.
- (4) casing PVC 445'
 (material) (depth)

(size) if telescope see back.

- (5) screen 20' 445'
 (length) (depth to top)
- 2" PVC
 (size) (material)
- (6) pump 1/2 15
 (HP) (yield gpm)
- E/E
 (type power)

- (7) electric log (yes or no)

(organization running log)

- (8) how well bottom plugged Clayton
marks 2"

DRILLERS REMARKS:

description of formations encountered

from to


Clay	0	7
Sand	7	30
Big gravel	30	35
Clay	40	70
med Sand	70	90
Clay	90	130
Sand	130	135
Clay	135	180
Sand	180	195
Clay	195	210
Sand	260	264
Clay	264	330
fine Sand	330	350
med. Sand	350	380
Clay	380	390
med white Sand	390	445
Sand	445	465

DEPT. OF NATURAL RESOURCES
 BUREAU OF LAND & WATER RESOURCES

MAR 15 1980
 RECEIVED

If well telescopes please sketch and show depths.

GROUND LEVEL

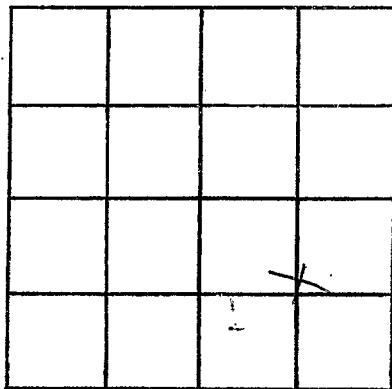

SECTION 10

Please indicate well location X.

ADDITIONAL INFORMATION

If more than one screen, show locations of each on sketch.