

*Perry*  
N 2005

MISSISSIPPI  
BOARD OF WATER COMMISSIONERS  
416 North State Street  
Jackson, Mississippi 39201

WATER WELL DRILLERS LOG

April 13 1982 *Parness Anderson Perry*  
date well completed firm name county well located

LANDOWNER: <i>Gordon Pearce</i>	description of formations encountered	from	to
<i>Rt 1</i>			
<i>Brooklyn Ms</i> (mailing address)	<i>Lap soil</i>	<i>0</i>	<i>2</i>
	<i>Clay</i>	<i>2</i>	<i>18</i>
	<i>sand</i>	<i>18</i>	<i>26</i>
	<i>Clay</i>	<i>26</i>	<i>120</i>
	<i>fine sand</i>	<i>120</i>	<i>138</i>
	<i>Clay</i>	<i>138</i>	<i>294</i>
	<i>fine sand</i>	<i>294</i>	<i>326</i>
	<i>Clay</i>	<i>326</i>	<i>460</i>
	<i>fine sand</i>	<i>460</i>	<i>494</i>
	<i>Coarse sand</i>	<i>494</i>	<i>520</i>

WELL LOCATION:

sec 3 T 1 N R 11  
11 miles E of Brooklyn  
 (distance) (direction) (nearest town)

WELL PURPOSE: Home  
 (home, irrigation, municipal, industrial)

WELL COMPLETION DATA:

- (1) diameter (inches) 2"
- (2) total depth (feet) 520'
- (3) static water level (feet) 75' below top of ground.
- (4) casing Pvc  
 (material) (depth)  
 (size) if telescope see back.
- (5) screen 10' 510'  
 (length) (depth to top)  
 (size) Pvc  
 (material)
- (6) pump 1 9  
 (HP) (yield gpm)  
Electric  
 (type power)
- (7) electric log NO  
 (yes or no)  
 (organization running log)
- (8) how well bottom plugged Capped

DRILLERS REMARKS:


DEPT. OF NATURAL RESOURCES  
BUREAU OF LAND & WATER RESOURCES

JUN - 9 1982

RECEIVED

If well telescopes please sketch and show depths.

GROUND LEVEL

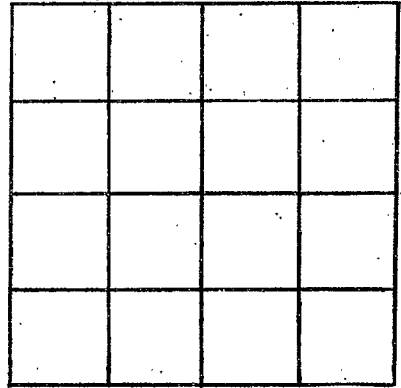

SECTION \_\_\_\_\_

Please indicate well location X.

ADDITIONAL INFORMATION

If more than one screen,  
show locations of each on sketch.