

**MISSISSIPPI DEPARTMENT OF NATURAL RESOURCES**  
**Bureau of Land and Water Resources**  
 Southport Mall  
 P.O. Box 10631  
 Jackson, Mississippi 39209  
**WATER WELL DRILLERS LOG**

Perry  
N 2006

July 2 1982 date well completed      Cochran Geo. Davis firm name      Perry county well located

LANDOWNER:	description of formations encountered	from	to
<u>W. H. Dean</u> <u>Rt 3 Brookland</u> (mailing address)	<u>TOP Soil</u>	<u>0</u>	<u>2</u>
	<u>Red clay</u>	<u>2</u>	<u>6</u>
	<u>Red sand</u>	<u>6</u>	<u>13</u>
	<u>GRAY clay</u>	<u>13</u>	<u>26</u>
	<u>sand</u>	<u>26</u>	<u>52</u>
<b>WELL LOCATION:</b> sec. <u>19</u> T. <u>1</u> N. R. <u>11</u> E. <u>1</u> miles <u>South</u> of <u>Jamie</u> (distance) (direction) (nearest town)			
<b>WELL PURPOSE:</b> <u>home</u> (home, irrigation, municipal, industrial)			
<b>WELL COMPLETION DATA:</b> (1) diameter (inches) <u>2"</u> (2) total depth (feet) <u>52'</u> (3) static water level (feet) <u>31</u> <u>below</u> above top of ground. (4) casing <u>PVC</u> <u>47'</u> (material) (depth) (size) if telescope see back. (5) screen <u>5'</u> <u>47'</u> (length) (depth to top) <u>2"</u> <u>PVC</u> (size) (material) (6) pump <u>1</u> (HP) (yield gpm) <u>Elec</u> (type power) (7) electric log <u>no</u> (yes or no) (organization running log) (8) how well bottom plugged <u>valve</u>			

DRILLERS REMARKS:


DEPT. OF NATURAL RESOURCES  
 BUREAU OF LAND & WATER RESOURCES

OCT - 4 1982

**RECEIVED**

If well telescopes please sketch and show depths.

GROUND LEVEL

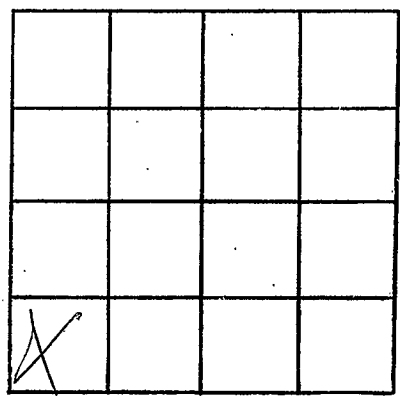

SECTION 19

Please indicate well location X.

ADDITIONAL INFORMATION

Lined area for additional information.

If more than one screen, show locations of each on sketch.