

MISSISSIPPI DEPARTMENT OF NATURAL RESOURCES

Bureau of Land and Water Resources

Southport Mall

P.O. Box 10631

Jackson, Mississippi 39209

WATER WELL DRILLERS LOG

Perry
N 2007

5-7-
date well completed

19 86 Frank Price Perry
firm name

county well located

LANDOWNER:
Ken Nixon

(mailing address)

description of formations encountered	from	to
<u>Top Soil</u>	<u>0</u>	<u>2</u>
<u>Blue Clay</u>	<u>2</u>	<u>450</u>
<u>Crunch Sand</u>	<u>450</u>	<u>473</u>

WELL LOCATION:
sec. 16 T. 1 N. R. 11 E.
S. W.
4 miles NE of Jamco
(distance) (direction) (nearest town)

WELL PURPOSE: HOME
(home, irrigation, municipal, industrial)

- WELL COMPLETION DATA:
- (1) diameter (inches) 2"
 - (2) total depth (feet) 473'
 - (3) static water level (feet) 100' below above top of ground.
 - (4) casing PVC, 4108'
(material) (depth)
(size) if telescope see back.
 - (5) screen 10', 4108'
(length) (depth to top)
2", PVC
(size) (material)
 - (6) pump 1, 10
(HP) (yield gpm)
Elect.
(type power)
 - (7) electric log No.
(yes or no)

(organization running log)
 - (8) how well bottom plugged B.W.V.


RECEIVED
AUG 18 1996

Department of Natural Resources
Bureau of Land & Water Resources

DRILLERS REMARKS:

If well telescopes please sketch and show depths.

GROUND LEVEL

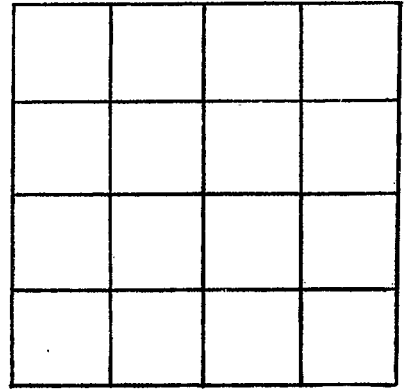

SECTION _____

Please indicate well location X.

ADDITIONAL INFORMATION

If more than one screen, show locations of each on sketch.