

MISSISSIPPI DEPARTMENT OF ENVIRONMENTAL QUALITY

Office of Land and Water Resources

P. O. Box 10631
Jackson, MS 39289-0631
WATER WELL DRILLERS LOG

COUNTY WELL LOCATED <u>Perry</u>	
WELL NUMBER <u>N-9019</u>	CODED
DATE WELL COMPLETED <u>March 25 2002</u>	

PERMIT NUMBER
NAME OF DRILLING FIRM <u>K+T Drilling</u>

NAME & MAILING ADDRESS OF LANDOWNER <u>Trees from turn oak</u> <u>Janice miss</u>			
WELL LOCATION: SEC	TOWNSHIP	RANGE	
<u>5</u>	<u>T1</u>	<u>N</u>	<u>R11</u> ^E _W
DISTANCE	DIRECTION	NEAREST TOWN	
<u>3</u> Miles	<u>south</u>	<u>Janice</u>	
OTHER LANDMARK			
WELL PURPOSE: Home <u>Irrigation</u> Municipal, Industrial, Fish Pond, etc.			

PUMP DATA		
PUMP TYPE (Circle One): <u>Submersible</u> , Turbine, Jet, Flowing Well, Other (Describe) _____		
POWER TYPE (Circle One): <u>Electric</u> , Tractor, Diesel, Gasoline, Butane, Other (Describe) _____ H/P <u>5</u>		
Pump Capacity (GPM) <u>80</u>	No. of Stages	Setting Depth FT.
PUMP TEST		
Well yielded <u>80</u> GPM with a drawdown of _____ ft. after _____ hours of pumping		

WELL DATA		
Well Depth <u>380</u>	Casing Diameter (In.) <u>4</u>	Casing Length (Ft.) <u>360</u>
Type of Casing <u>Pvc</u>	Hole Depth <u>380</u>	Depth to Static Water Level <u>25</u>

LOG DATA	
TYPE OF LOG RUN (Circle One): <u>No Log Run</u> , Electric, Gamma Ray, Density, Sonic, Neutron, Other (Describe) _____	
Name of Organization Running Log	

TYPE OF COMPLETION: (Circle One or More):
 Gravel Packed, Underreamed, Telescoped,
 Natural Development, Open Hole, Other
 (Describe) _____

GEOLOGIC DATA (Office Use Only)			
Surface Elev.	Geologic Unit	Unit Thickness	Depth to Top
Subs. SWL	Date	Analysis	Aquifer Test

WELL GROUTED TO A DEPTH OF 10 FEET
 Type Grout (circle one): Cement, Bentonite, or Mix

Driller's Remarks
Top of Lap Pipe or Reduction in Casing
FEET
IF TELESKOPED OR MORE THAN ONE SCREEN: USE BACK PAGE


SCREEN DATA		
Diameter - Inches <u>4</u>	Length - Feet <u>20</u>	Slot Size - Inches <u>12</u>
Screen Type <u>Pvc</u>	Depth to Bottom - Feet <u>380</u>	

DESCRIPTION OF FORMATIONS ENCOUNTERED	FROM	TO	FORMATIONS (Continued)	
			FROM	TO
<u>Top soil</u>	<u>0</u>	<u>10</u>		
<u>Sand</u>	<u>10</u>	<u>20</u>		
<u>clay</u>	<u>20</u>	<u>300</u>		
<u>sand</u>	<u>300</u>	<u>380</u>		

IF MORE SPACE IS NEEDED, USE BACK

If well telescopes please
sketch and show depths.

GROUND LEVEL

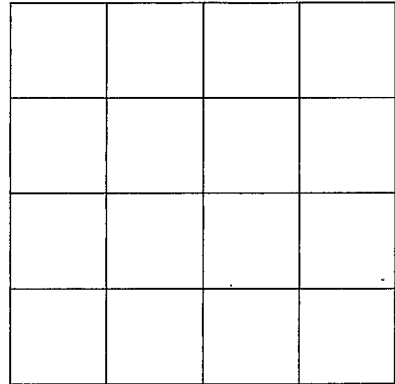

SECTION _____

Please indicate well location X.

ADDITIONAL INFORMATION

If more than one screen,
show location of each on sketch.