

PERRY
 09
 3-31-71

MISSISSIPPI
 BOARD OF WATER COMMISSIONERS
 416 North State Street
 Jackson, Mississippi 39201

CODED

WATER WELL DRILLERS LOG

3-31 1971 date well completed
 Lewis Smith firm name
 Perry county well located

LANDOWNER:
 Davis Davis

description of formations encountered	from	to
Top 8	0	2
clay	2	12
Sand	12	43
clay		

(mailing address)

WELL LOCATION:
 sec. 18 T. 1 N R. 10 E
 2 miles N of Jarvis
 (distance) (direction) (nearest town)

WELL PURPOSE:
 (home, irrigation, municipal, industrial)

WELL COMPLETION DATA:

- (1) diameter (inches) 2
- (2) total depth (feet) 43
- (3) static water level (feet) 22 below top of ground.
- (4) casing Plastic (material) (depth)
- (size) if telescope see back.
- (5) screen 5' 38" (length) (depth to top)
- (size) (material)
- (6) pump 1 (HP) 14 (yield gpm)
- (type power)
- (7) electric log (yes or no)
- (organization running log)
- (8) how well bottom plugged C&S

CODED


APR 19 1971

MISS. Bd. of WATER COMMISSIONERS

DRILLERS REMARKS:

If well telescopes please sketch and show depths.

GROUND LEVEL

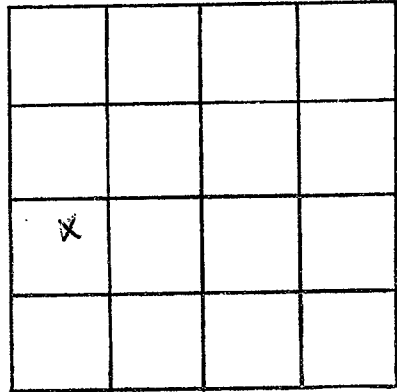

SECTION _____

Please indicate well location X.

ADDITIONAL INFORMATION

If more than one screen,
show locations of each on sketch.