

PERRY  
 Ø 12  
 1-13-71

MISSISSIPPI  
 BOARD OF WATER COMMISSIONERS  
 416 North State Street  
 Jackson, Mississippi 39201

**CODED**

WATER WELL DRILLERS LOG

1-13 1971 Farmer Anderson Perry  
 date well completed firm name county well located

LANDOWNER: B.B. Breland  
New Augusta  
 (mailing address)

description of formations encountered	from	to
<del>Top</del> Soil	0	3
Red Clay	3	30
Fine Red Sand	30	30
Red Clay	30	65
Fine Sand	65	80
Coarse Sand	80	91

WELL LOCATION:  
 sec. 23 T. 1 N. R. 10 E  
 (distance) miles (direction) of (nearest town)

WELL PURPOSE: Home  
 (home, irrigation, municipal, industrial)

WELL COMPLETION DATA:

(1) diameter (inches) 2"

(2) total depth (feet) 91

(3) static water level (feet) 56 below above top of ground.

(4) casing Plastic (material) (depth) (size) If telescope see back.

(5) screen 6' (length) (depth to top) 2" (size) Plastic (material)

(6) pump 1/2 (HP) 4 (yield gpm) Electric (type power)

(7) electric log No (yes or no)

(organization running log)

**CODED**

(8) how well bottom plugged: Backwash Valve


DRILLERS REMARKS:

JUN 3 1971

MISS. DIV. OF WATER CONTROL

If well telescopes please sketch and show depths.

GROUND LEVEL

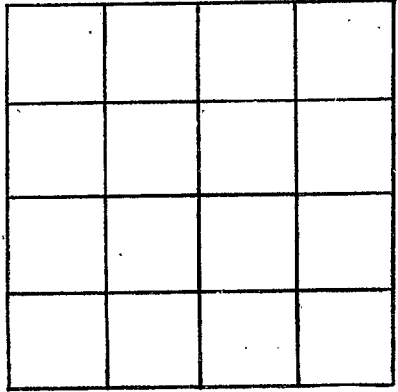

SECTION \_\_\_\_\_

Please indicate well location X.

ADDITIONAL INFORMATION

If more than one screen, show locations of each on sketch.