

PERRY
 013
 2-10-72

MISSISSIPPI
 BOARD OF WATER COMMISSIONERS
 416 North State Street
 Jackson, Mississippi 39201

CODED

WATER WELL DRILLERS LOG

Feb 10, 1972 Cochran Drilling Inc Perry
 date well completed firm name county well located

LANDOWNER: Oscar Mifon
 RT 2
 New Augusta
 (mailing address)

description of formations encountered	from	to
Top soil	0	2
red sand	2	11
red clay	11	13
gray clay	13	21
tan sf	21	42

WELL LOCATION:
 sec. 18 T. 1 N. R. 10 E
 S W
 4 miles W of Joice
 (distance) (direction) (nearest town)

WELL PURPOSE: home
 (home, irrigation, municipal, industrial)

- WELL COMPLETION DATA:
- (1) diameter (inches) 2
 - (2) total depth (feet) 42
 - (3) static water level (feet) 18 below top of ground.
 - (4) casing P.V.C. 37'
 (material) (depth)
 - (size) if telescope see back.
 - (5) screen 5' 37'
 (length) (depth to top)
 - 2" P.V.C.
 (size) (material)
 - (6) pump 1 6 1/2
 (HP) (yield gpm)
 - Elect.
 (type power)
 - (7) electric log No.
 (yes or no)
 - (organization running log)
 - (8) how well bottom plugged Valve

CODED


MAY 9 1972

MISS. REG. OFF.
 WATER UTILITIES

DRILLERS REMARKS:

If well telescopes please sketch and show depths.

GROUND LEVEL

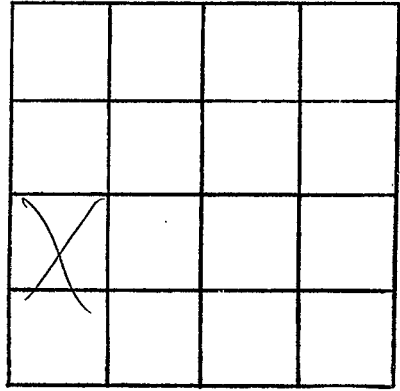

SECTION

18

Please indicate well location X.

ADDITIONAL INFORMATION

If more than one screen,
show locations of each on sketch.