

Perry
 014
 6-13-73

MISSISSIPPI
 BOARD OF WATER COMMISSIONERS
 416 North State Street
 Jackson, Mississippi 39201

CODE

WATER WELL DRILLERS LOG

6-13 date well completed 1973 firm name Parnell Anderson Perry county well located

LANDOWNER: Katherine Felling
 New Augusta
 (mailing address)

Description of formations encountered	from	to
TOP Soil	0	3
Sandy Clay	3	16
Fine Sand	16	31
Pink Clay	31	37
Fine Sand	37	44
Coarse Sand	44	53

WELL LOCATION:
 sec 22 T 1 N R 10 W
 15 miles S of New Augusta
 (distance) (direction) (nearest town)

WELL PURPOSE: Home
 (home, irrigation, municipal, industrial)

- WELL COMPLETION DATA:
- (1) diameter (inches) 2
 - (2) total depth (feet) 58
 - (3) static water level (feet) 30 below top of ground.
 - (4) casing Plastic, 53 (material), (depth)
 - (size) if telescope see back.
 - (5) screen 5, 53 (length), (depth to top)
 - (size), (material)
 - (6) pump 1/2, 5 (HP), (yield gpm)
 - Elec (type power)
 - (7) electric log (yes or no)
 - (organization running log)
 - (8) how well bottom plugged Backwash Valve




DRILLERS REMARKS:

NOV 5 1973

If well telescopes please sketch and show depths.

GROUND LEVEL

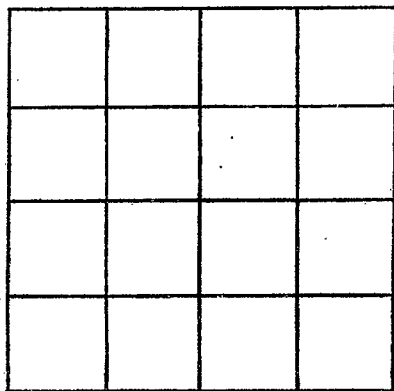

SECTION _____

Please indicate well location X.

ADDITIONAL INFORMATION

If more than one screen, show locations of each on sketch.