

Perry
 Φ 15
 8-29-73

MISSISSIPPI
 BOARD OF WATER COMMISSIONERS
 416 North State Street
 Jackson, Mississippi 39201

CODP

WATER WELL DRILLERS LOG

8-24 19 3 Darnell Anderson Perry
 date well completed firm name county well located

LANDOWNER:
 V. V. Walters
 Wiggins MS
 (mailing address)

description of formations encountered	from	to
Top Soil	0	6
White Clay	6	44
Blue Clay	44	450
Coarse Sand	450	478

WELL LOCATION:
 sec. 17 T. 1 N R. 10 E
 17 miles NE of Wiggins
 (distance) (direction) (nearest town)

WELL PURPOSE: HOME
 (home, irrigation, municipal, industrial)

WELL COMPLETION DATA:

(1) diameter (inches) 2"

(2) total depth (feet) 478'

(3) static water level (feet) 135' below top of ground.

(4) casing Plastic, 473' (material) (depth)

(size) if telescope see back.

(5) screen 5' 473' (length) (depth to top)
 2" Plastic (size) (material)

(6) pump 1 (HP) 4 (yield gpm)
 Electricity (type power)

(7) electric log no (yes or no)

(organization running log)

(8) how well bottom plugged Backwash Valve




DRILLERS REMARKS:

NOV 5 1973

If well telescopes please sketch and show depths.

GROUND LEVEL

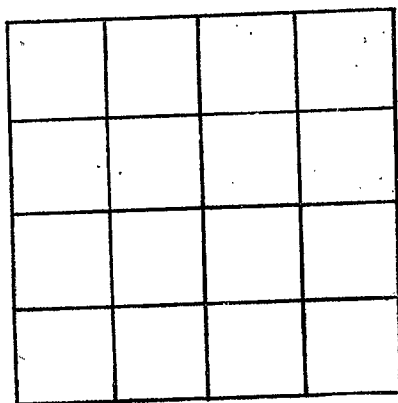

SECTION _____

Please indicate well location X.

ADDITIONAL INFORMATION

If more than one screen,
show locations of each on sketch.