

Perry
 #17
 3-11-74

MISSISSIPPI
 BOARD OF WATER COMMISSIONERS
 416 North State Street
 Jackson, Mississippi 39201

CODED

WATER WELL DRILLERS LOG

3-11 date well completed 1974 Parnell Anderson firm name Perry county well located

LANDOWNER:

James Bryant
 Rt 1 Brooklyns
 (mailing address)

description of formations encountered

	from	to
Top Soil	0	3
white Clay	3	14
Course Sand	14	32

WELL LOCATION:

sec 7 T 1 N R 10 W
 4 miles N of Jerald
 (distance) (direction) (nearest town)

WELL PURPOSE: HOME
 (home, irrigation, municipal, industrial)

WELL COMPLETION DATA:

- (1) diameter (inches) 2"
- (2) total depth (feet) 32'
- (3) static water level (feet) 26' below top of ground.
- (4) casing Plastic 27' (material) (depth)
- (size) If telescope see back.
- (5) screen 5' 28' (length) (depth to top)
- 2" Plastic (size) (material)
- (6) pump 1/2 (HP) 8 (yield gpm)
- Elect (type power)
- (7) electric log no (yes or no)
- no (organization running log)
- (8) how well bottom plugged Backwash valve


CODED

DRILLERS REMARKS:

MISSISSIPPI
 BOARD OF WATER COMMISSIONERS
 Jackson, Mississippi

If well telescopes please sketch and show depths.

GROUND LEVEL

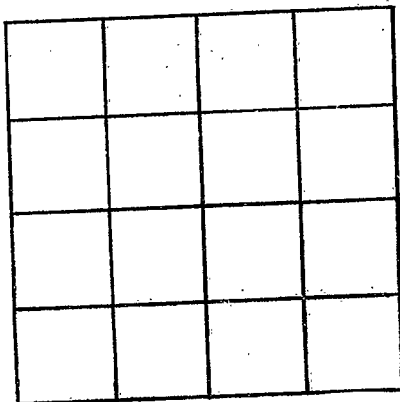

SECTION _____

Please indicate well location X.

ADDITIONAL INFORMATION

If more than one screen, show locations of each on sketch.