

Perry
 018
 7-12-74

MISSISSIPPI
 BOARD OF WATER COMMISSIONERS CODED
 416 North State Street
 Jackson, Mississippi 39201

WATER WELL DRILLERS LOG

3-12-74 date well completed
 1974 Pamela Anderson Perry firm name
 Perry county well located

LANDOWNER:

Monroe H Wilson
 HIGHWAY 19 NORTH
 (mailing address)

description of formations encountered

from to

Top Soil 0 4
 Fine Sand 4 30
 Coarse Sand 30 45

WELL LOCATION:

sec. 10 T. 7 N. R. 10 E.
 16 miles NE of Wiggins
 (distance) (direction) (nearest town)

WELL PURPOSE: HOME
 (home, irrigation, municipal, industrial)

WELL COMPLETION DATA:

- (1) diameter (inches) 2"
 (2) total depth (feet) 45'
 (3) static water level (feet) 38' below top of ground.
 (4) casing ~~Steel~~ 40'
 (material) (depth)
 (size) if telescope see back.
 (5) screen 5' 40'
 (length) (depth to top)
 2" Plastic
 (size) (material)
 (6) pump 1 7
 (HP) (yield gpm)
 Elect
 (type power)
 (7) electric log NO
 (yes or no)

CODED

(organization running log)


(8) how well bottom plugged
 Plugged

DRILLERS REMARKS:

RECEIVED
 AUG - 2 1974

If well telescopes please sketch and show depths.

GROUND LEVEL

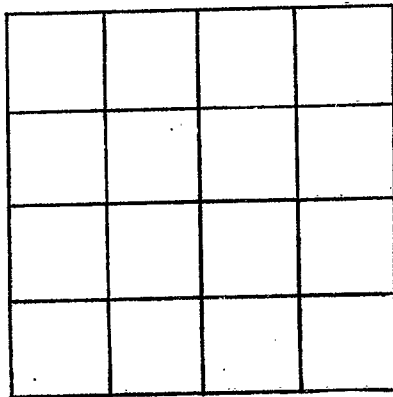

SECTION _____

Please indicate well location X.

ADDITIONAL INFORMATION

If more than one screen, show locations of each on sketch.