

Perry  
019  
10-2-74

MISSISSIPPI  
BOARD OF WATER COMMISSIONERS  
416 North State Street  
Jackson, Mississippi 39201 **CODED**

WATER WELL DRILLERS LOG

10-2 1974 *Perrell Anderson* Perry  
date well completed firm name county well located

LANDOWNER: <i>Thomas Wilson</i>	description of formations encountered	from	to
 <i>(mailing address)</i>	<i>Top Soil</i>	<i>0</i>	<i>4</i>
	<i>Red clay</i>	<i>4</i>	<i>18</i>
WELL LOCATION: sec <u>10</u> T <u>1</u> N R <u>10</u> E E W	<i>Fine Sand</i>	<i>18</i>	<i>64</i>
<i>16</i> miles <i>N</i> of <i>Wlogg</i> (distance) (direction) (nearest town)	<i>Coarse Sand</i>	<i>64</i>	<i>95</i>

WELL PURPOSE: *Industrial*  
(home, irrigation, municipal, industrial)

- WELL COMPLETION DATA:
- (1) diameter (inches) 2"
- (2) total depth (feet) 85'
- (3) static water level (feet) 38' below top of ground.
- (4) casing Plastic 20'  
(material) (depth)  
(size) If telescope see back.
- (5) screen 5' 80'  
(length) (depth to top)  
2" Plastic  
(size) (material)
- (6) pump 1 10  
(HP) (yield gpm)  
Elect  
(type power)
- (7) electric log no  
(yes or no)

**CODED**

(organization running log)


(8) how well bottom plugged  
*Plugged*

DRILLERS REMARKS:

**RECEIVED**  
**NOV 12 1974**

If well telescopes please sketch and show depths.

GROUND LEVEL

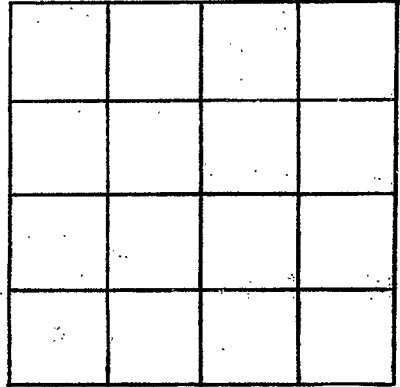

SECTION \_\_\_\_\_

Please indicate well location X.

ADDITIONAL INFORMATION

If more than one screen, show locations of each on sketch.