

Perry  
 20  
 10-1-74

MISSISSIPPI  
 BOARD OF WATER COMMISSIONERS  
 416 North State Street  
 Jackson, Mississippi 39201

CODED

WATER WELL DRILLERS LOG

10-1  
 date well completed

1974 Parnell Anderson  
 firm name

Perry  
 county well located

LANDOWNER:

Bob Wilson

(mailing address)

description of formations encountered

from to

Top Soil

0 3

Red Clay

4 18

Fine Sand

18 64

Coarse Sand

64 88

WELL LOCATION:

sec. 10 T 1 N R 10 W  
16 miles N of Wegg  
 (distance) (direction) (nearest town)

WELL PURPOSE:

Industrial  
 (home, irrigation, municipal, industrial)

CODED

WELL COMPLETION DATA:

- (1) diameter (inches) 4"
- (2) total depth (feet) 85'
- (3) static water level (feet) 48 below top of ground.
- (4) casing Plastic, 80'  
 (material) (depth)

if telescope see back.  
 (size)

- (5) screen 5" 80'  
 (length) (depth to top)  
1" Plastic  
 (size) (material)

- (6) pump 1 9  
 (HP) (yield gpm)  
Elect  
 (type power)


- (7) electric log no  
 (yes or no)

(organization running log)

- (8) how well bottom plugged

Plugged

DRILLERS REMARKS:

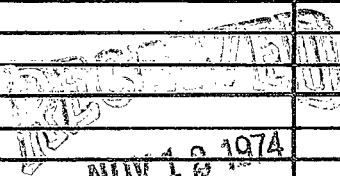


NOV 18 1974

MISS. BB. OF WATER COM.

If well telescopes please  
sketch and show depths.

GROUND LEVEL

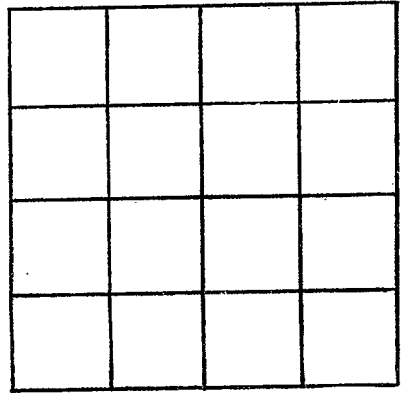

SECTION \_\_\_\_\_

Please indicate well location X.

ADDITIONAL INFORMATION

If more than one screen,  
show locations of each on sketch.