

State Well Report

Part 1 - Driller's Log

Mississippi Department of Environmental Quality
 Office of Land and Water Resources
 P.O. Box 2309
 Jackson, MS 39225
 (601)961- 5210
 (601)961- 5228 (fax)

For Office Use Only:

Aquifer: _____
 Well #: 042
 L. S. Elevation: _____
 E-log #: _____

County: Perry
 Permit #: _____
 Driller: David L. Cain
 Date drilling completed: 5-11-2017

State Law requires that this report be prepared by the license holder responsible for the work and filed with the Department at the above address within 30 days of completion of drilling of the well or borehole.

#2 Well

Information on Well Owner (Landowner if borehole is not for a water well)	Well or Borehole Location
Owner Name: <u>Daniel Sherman</u>	Latitude: <u>31° 03' 17"</u> Longitude: <u>88° 58' 45"</u>
Mailing Address: <u>2580 Hwy 29</u>	Method of Lat/Long (circle one): Conventional Survey, USGS quad, Hand-held GPS, Survey-grade GPS
<u>Brooklyn MS 39425</u>	NE 1/4 NE 1/4 Sec <u>10</u> ¹⁵ Twn <u>1 N</u> ¹⁵ Rng <u>10 W</u>
City State Zip Code	Distance Direction Nearest Town
Telephone No. <u>(601) 528-3609</u>	<u>10</u> Miles <u>South</u> of <u>New Augusta MS</u>

Well / Borehole Data

Date drilling started: 5-9 Date drilling completed: 5-11 Hole depth: 90' Hole diameter: 4"

Location of the source of any surface water used for drilling: his other water well
 Method of dosing and volume of Chlorine used in drilling and development: _____

Logs run (circle all applicable): No log run Electric Gamma Ray Density Sonic Neutron Other: _____
 Name of organization running log(s): _____

Purpose of borehole (check one): Water Well Geotechnical/Geological Investigation _____ Ground Source Heat Pump _____
 Seismic Survey _____ Other (describe) _____

If drilling is not related to water well construction, skip the remainder of this block

Purpose of Well (check one): Home _____ Industrial Public Supply _____ Irrigation _____ Fish Culture _____ Other: Chicken Farm

If a flowing well, method of flow regulation: Valve _____ Other (describe) _____
 Static Water Level: 50 feet above of below (circle one) land surface Date measured: 5-11-2017

Method of Measurement (circle one) steel tape electric tape air line other: String line

Well depth: 90' Well grouted to a depth of 25 feet Type of grout (circle one): Neat Cement Bentonite Mix

Casing length: 80 feet Casing diameter: 4" inches Type of casing: PVC

Screen length: 10 feet Screen diameter: 4" inches Type of screen: PVC

Screen slot size: #10 inches Setting depth: From 80 feet to 90 feet

Type of completion (circle all applicable): Gravel packed Underreamed Telescoped Open hole Natural Development
 Other (describe): _____

Top of lap pipe or reduction in casing: _____ feet. **If telescoped or more than one screen, describe on next page**

RECEIVED
 JUN 02 2017

BY OLWR

Southern MS Water Well Drilling #0-831

Form: OLWR-SWR-1A (04/08)

Randall Cain 5/31/2017

1. The first part of the document discusses the importance of maintaining accurate records of all transactions. It emphasizes that this is crucial for the company's financial health and for providing reliable information to stakeholders.

2. The second part of the document outlines the specific procedures for recording transactions. It details the steps from initial entry to final review, ensuring that all entries are properly categorized and verified.

3. The third part of the document addresses the role of the accounting department in monitoring and controlling the company's resources. It highlights the need for regular audits and the implementation of internal controls to prevent fraud and errors.

4. The fourth part of the document discusses the impact of financial reporting on the company's overall performance. It explains how accurate and timely reports can help management make informed decisions and improve the company's financial position.

5. The fifth part of the document provides a summary of the key points discussed in the previous sections. It reiterates the importance of accuracy, transparency, and regular communication in the financial reporting process.

6. The sixth part of the document offers some final thoughts on the future of financial reporting. It suggests that as technology continues to advance, companies should explore new ways to streamline their reporting processes and enhance the quality of their data.

7. The seventh part of the document concludes with a call to action, encouraging all employees to take responsibility for their role in maintaining accurate financial records and contributing to the company's long-term success.

STATE WELL REPORT

Part 2

Pump Installer's Completion Report
Mississippi Department of Environmental Quality
Office of Land and Water Resources

P.O. Box 2309
Jackson, MS 39225
(601)961-5210
(601)961-5228 (fax)

For Office Use Only:

Aquifer: _____

Well #: 042

Elevation: _____

County: Pearry

Permit #: _____

Driller: David L. Cain

Date completed: 5-11-2017

Copy information from block on Part 1

This part of the report must be completed by a licensed water well contractor or a licensed pump installer. A copy of Part 1 of the report must be attached and both parts filed with the Department at the above address within 30 days of well completion.

Well Owner Information

Owner Name: Daniel Sherman

Mailing Address: 2580 Hwy 29

Brooklyn Ms 39425
City State Zip Code

Telephone No. (601) 528-3609

Well Location

Latitude: 31° 03' 17" Longitude: 88° 58' 45"

Method of Lat/Long (check one): Conventional Survey _____

USGS quad Hand-held GPS Survey-grade GPS _____

S $\frac{1}{4}$ R $\frac{1}{4}$ Sec 10 T 1N R 10W
NE NE 15

Distance Direction Nearest Town

10 Miles South of New Augusta Ms
39462

Pump Type
Circle one

Air Lift Jet Submersible
Bucket Piston Turbine
Centrifugal Rotary Flowing Well

Other (specify): _____

Date Pump Installed: 5-11-2017

Rated Pump Capacity: 30 Gallons Per Minute

Power Type
Circle one

Diesel Engine Gasoline Engine Natural Gas
Electric Motor Hand Tractor PTO
Windmill Other (specify): _____

Horse Power Rating of Motor: 3 hp

Setting Depth: 85 feet

Number of Stages: 15

Pump Test Data

Date Well Tested: 5-11-2017

Static Water Level (A): 50 Feet Below Land Surface

Pumping Water Level (B): 80 Feet Below Land Surface

Drawdown [(B) - (A)]: 30 Feet Below Land Surface

Test Pumping Rate: 60 Gallons Per Minute

Duration of Pump Test (minimum 4 hours): 4 hours

Method of Measuring Water Level
Circle one

Air Line Electric Measuring Line Steel Tape
Other (specify): String line

For flowing well, measured shut in head: _____ feet

Well yielded 60 GPM with a drawdown of

30 feet after 1 hours of pumping

RECEIVED
JUN 03 2017
BY OLWR

I HEREBY CERTIFY that the above statements are true to the best of my knowledge.

Southern Ms Water Well Drilling
Print Name of Pump Installer and License No. (if applicable)

David L. Cain 5-31-2017
Signature of Pump Installer


#0-831

Form: OLWR-SWR-1B (04/08)

The sketch below only required for water wells.

Description of formations encountered must be provided for all wells and boreholes, unless specifically exempted by regulations

If well telescopes, show depths on sketch.

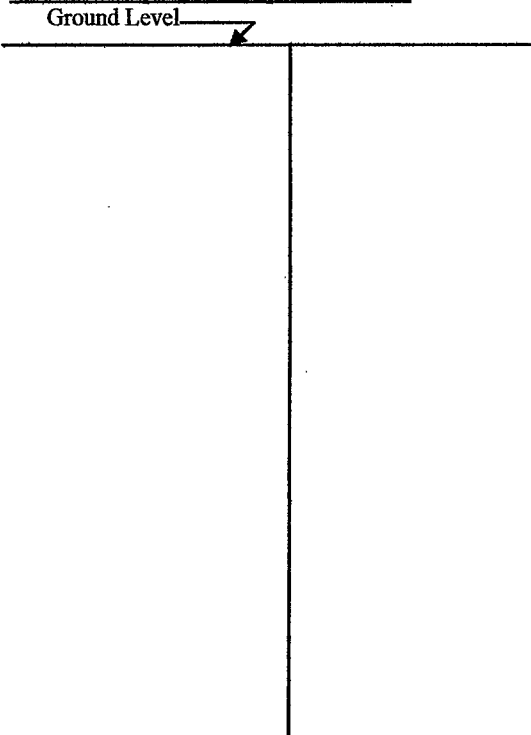

Description of Formations Encountered	From (depth)	To (depth)
Topsoil	Ground Level	30
Clay	30	90
Sand		

If more than one screen, show location of each on sketch

Sketch the property layout and include the following: 1) the well location; 2) any permanent structures on the property that may aid in locating the well; 3) any roads, power lines, or other items that may aid in locating the property and the well; 4) a north arrow.

RECEIVED
JUN 02 2017
BY OLWR

Landowner Name: Daniel Sherman

Form: OLWR-SWR-1A (04/08)

I certify that the well/borehole was drilled, constructed, and completed in accordance with all applicable requirements of the Mississippi Department of Environmental Quality and the Mississippi Department of Health regulations, if applicable, and state laws.

Southern MS Water Well Drilling 5-31-2017 Randall Cain

Print Name of Responsible Licensee and License No. # 0-831 Date Signature of Licensee