

*Perry*  
 200  
 9-9-76

MISSISSIPPI  
 BOARD OF WATER COMMISSIONERS  
 416 North State Street  
 Jackson, Mississippi 39201

132

WATER WELL DRILLERS LOG

*Perry*

9-9  
 date well completed

1976 *Barnell Anderson*  
 firm name

county well located


LANDOWNER:	description of formations encountered	from	to
<i>James Cooley</i>	<i>Top Soil</i>	0	4
(mailing address)	<i>Coarse Sand</i>	4	35
WELL LOCATION:	<i>Blue Clay</i>	35	105
sec. <u>30</u> T. <u>1</u> S. R. <u>10</u> W.	<i>Flint Sand</i>	105	112
(distance) miles <u>5</u> of <i>Jankin</i>	<i>Blue Clay</i>	112	164
(direction) (nearest town)	<i>Flint Sand</i>	164	170
WELL PURPOSE: <u>170 M.F.</u>	<i>Coarse Sand</i>	170	181
(home, irrigation, municipal, industrial)			
WELL COMPLETION DATA:			
(1) diameter (inches) <u>2"</u>			
(2) total depth (feet) <u>181'</u>			
(3) static water level (feet) <u>102</u> below top of ground.			
(4) casing <u>Plastic 176'</u> (material) (depth)			
(size) If telescope see back.			
(5) screen <u>5"</u> <u>176'</u> (length) (depth to top)			
<u>2"</u> <u>Plaster</u> (size) (material)			
(6) pump <u>1</u> <u>5</u> (HP) (yield gpm)			
<u>Elect</u> (type power)			
(7) electric log <u>no</u> (yes or no)			
(organization running log)			
(8) how well bottom plugged <u>Backum valve</u>			
DRILLERS REMARKS:			

RECEIVED  
 OCT - 8 1976

MISS. BD. OF WATER COMMISSIONERS

If well telescopes please sketch and show depths.

GROUND LEVEL

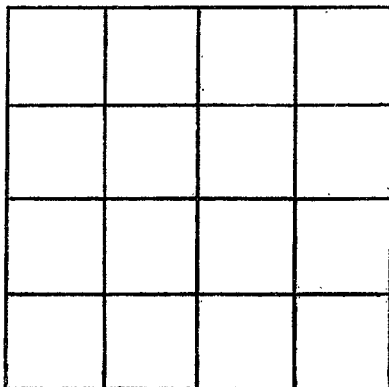

SECTION \_\_\_\_\_

Please indicate well location X.

ADDITIONAL INFORMATION

If more than one screen, show locations of each on sketch.