

Perry  
 6-8-77

MISSISSIPPI  
 BOARD OF WATER COMMISSIONERS  
 416 North State Street  
 Jackson, Mississippi 39201

WATER WELL DRILLERS LOG

6-8 date well completed 1977 firm name Pernell Anderson Perry county well located Perry

| LANDOWNER:   | description of formations encountered | from      | to         |
|--|---------------------------------------|-----------|------------|
| <u>James Barnes</u>  | <u>Top Soil</u>                       | <u>0</u>  | <u>4</u>   |
| (mailing address)  | <u>Fine Sand</u>                      | <u>4</u>  | <u>92</u>  |
| WELL LOCATION:   | <u>Coarse Sand</u>                    | <u>92</u> | <u>105</u> |
| sec. <u>14</u> T. <u>1</u> N. R. <u>10</u> W.                |                                       |           |            |
| <u>4 1/2</u> miles <u>NE</u> of <u>Janice</u>                |                                       |           |            |
| (distance) (direction) (nearest town)                        |                                       |           |            |
| WELL PURPOSE: <u>HOME</u>                                    |                                       |           |            |
| (home, irrigation, municipal, industrial)                    |                                       |           |            |
| WELL COMPLETION DATA:  |                                       |           |            |
| (1) diameter (inches) <u>2"</u>                              |                                       |           |            |
| (2) total depth (feet) <u>105</u>                            |                                       |           |            |
| (3) static water level (feet) <u>52</u> below top of ground. |                                       |           |            |
| (4) casing <u>Plastic</u> <u>100'</u>                        |                                       |           |            |
| (material) (depth)   |                                       |           |            |
| (size) If telescope see back.                                |                                       |           |            |
| (5) screen <u>5'</u> <u>100'</u>                             |                                       |           |            |
| (length) (depth to top)                                      |                                       |           |            |
| <u>2"</u> <u>Plastic</u>                                     |                                       |           |            |
| (size) (material)  |                                       |           |            |
| (6) pump <u>1</u> <u>9</u>                                   |                                       |           |            |
| (HP) (yield gpm)   |                                       |           |            |
| <u>Elect</u>   |                                       |           |            |
| (type power)   |                                       |           |            |
| (7) electric log <u>No</u>                                   |                                       |           |            |
| (yes or no)  |                                       |           |            |
| (organization running log)                                   |                                       |           |            |
| (8) how well bottom plugged <u>Open</u>                      |                                       |           |            |


DRILLERS REMARKS:

RECEIVED  
 JUL 5 - 1977

MISS. BD. OF WATER COMMISSIONERS

If well telescopes please sketch and show depths.

GROUND LEVEL

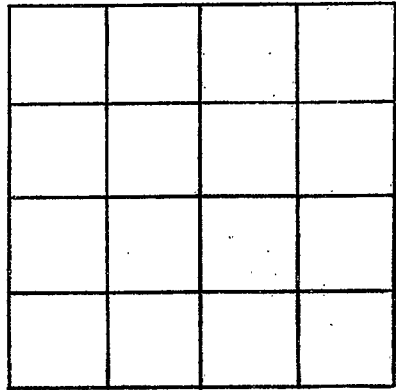

SECTION \_\_\_\_\_

Please indicate well location X.

ADDITIONAL INFORMATION

If more than one screen,  
show locations of each on sketch.