

Perry  
 2002  
 9/23/77

MISSISSIPPI  
 BOARD OF WATER COMMISSIONERS  
 416 North State Street  
 Jackson, Mississippi 39201

WATER WELL DRILLERS LOG

9-23-77 date well completed 1977 firm name *Parnell Anderson Perry* county well located

LANDOWNER:  
*Millard Wilson*  
 (mailing address)

description of formations encountered	from	to
<i>Top Soil</i>	<i>0</i>	<i>3</i>
<i>Sandy clay</i>	<i>3</i>	<i>18</i>
<i>Coarse Sand</i>	<i>18</i>	<i>85</i>

WELL LOCATION:  
 sec. *10* T. *1* N R. *10* W  
*5* miles *NE* of *Jacks*  
 (distance) (direction) (nearest town)

WELL PURPOSE: *DOMESTIC*  
 (home, irrigation, municipal, industrial)

WELL COMPLETION DATA:

(1) diameter (inches) *2"*

(2) total depth (feet) *85'*

(3) static water level (feet) *30'* below above top of ground.

(4) casing *Plastic* *80'*  
 (material) (depth)  
 (size) If telescope see back.

(5) screen *5"* *80'*  
 (length) (depth to top)  
*2"* *Plastic*  
 (size) (material)

(6) pump *1* *10*  
 (HP) (yield gpm)  
*E-test*  
 (type power)

(7) electric log *No*  
 (yes or no)

(organization running log)

(8) how well bottom plugged  
 *capped*


DRILLERS REMARKS:

RECEIVED  
 NOV - 8 1977

MISS. BD. OF WATER COMMISSIONERS

If well telescopes please sketch and show depths.

GROUND LEVEL

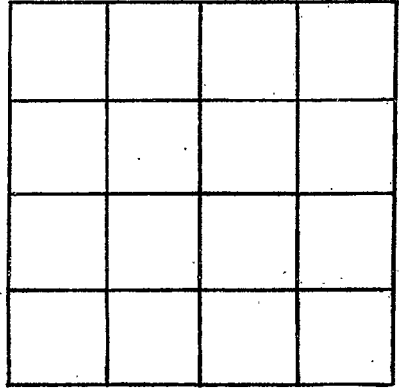

SECTION \_\_\_\_\_

Please indicate well location X.

ADDITIONAL INFORMATION

If more than one screen, show locations of each on sketch.