

Perry  
 B 2003  
 11/23/77

MISSISSIPPI  
 BOARD OF WATER COMMISSIONERS  
 416 North State Street  
 Jackson, Mississippi 39201

WATER WELL DRILLERS LOG

Perry  
~~\_\_\_\_\_~~

11-23 1977  
 date well completed

Panel Anderson  
 firm name

county well located


LANDOWNER:	description of formations encountered		from	to
Thomas Wilson	Top Soil		0	2
(mailing address)	Red Clay		2	18
WELL LOCATION:	Fine Sand		18	42
sec. 10 T. 1 N. W. R. 10 E	Red Clay		42	125
5 miles N of Janice	Coarse Sand		65	85
(distance) (direction) of (nearest town)				
WELL PURPOSE: HOME				
(home, irrigation, municipal, industrial)				
WELL COMPLETION DATA:				
(1) diameter (inches) 12"				
(2) total depth (feet) 85'				
(3) static water level (feet) 60' below top of ground.				
(4) casing Plastic, 80' (material) (depth)				
(size) If telescope see back.				
(5) screen 5' 80' (length) (depth to top)				
2" Plastic (size) (material)				
(6) pump 1 (HP) 10 (yield gpm)				
Elect (type power)				
(7) electric log no (yes or no)				
(organization running log)				
(8) how well bottom plugged: capped				
DRILLERS REMARKS:				

RECEIVED  
 DEC 6 1977

MISS. BD. OF WATER COMMISSIONERS

If well telescopes please sketch and show depths.

GROUND LEVEL

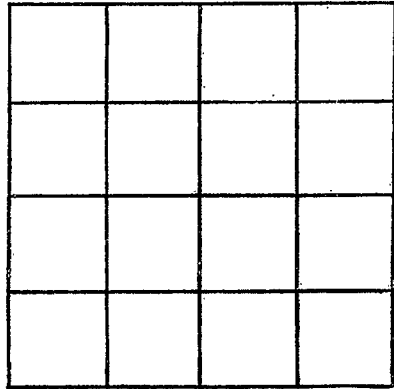

SECTION \_\_\_\_\_

Please indicate well location X.

ADDITIONAL INFORMATION

If more than one screen, show locations of each on sketch.