

Perry  
 2005  
 7-7-77

MISSISSIPPI  
 BOARD OF WATER COMMISSIONERS  
 416 North State Street  
 Jackson, Mississippi 39201

WATER WELL DRILLERS LOG

7-7 1977 *Fernell Perkins Perry*  
 date well completed firm name county well located

| LANDOWNER:<br><i>Albert Hinton</i> | description of formations encountered | from | to |
|------------------------------------|---------------------------------------|------|----|
|                                    |                                       |      |    |
| (mailing address)                  | <i>Top Soil</i>                       | 0    | 2  |
|                                    | <i>Sandy Clay</i>                     | 2    | 37 |
|                                    | <i>Hard Sand</i>                      | 37   | 48 |
|                                    | <i>Clay</i>                           | 48   | 65 |
|                                    | <i>Coarse Sand</i>                    | 65   | 78 |

WELL LOCATION:  
 sec. 14 T. 1 N. R. 10 E. S. W  
4 1/2 miles NE of Amice  
 (distance) (direction) (nearest town)

WELL PURPOSE: HOME  
 (home, irrigation, municipal, industrial)


- WELL COMPLETION DATA:
- (1) diameter (inches) 2"
  - (2) total depth (feet) 90'
  - (3) static water level (feet) 60' below above top of ground.
  - (4) casing Plastic, 85'  
 (material) (depth)  
 (size) If telescope see back.
  - (5) screen 5' - 85'  
 (length) (depth to top)  
2" Plastic  
 (size) (material)
  - (6) pump 1 8  
 (HP) (yield gpm)  
Elect  
 (type power)
  - (7) electric log no  
 (yes or no)
  - (organization running log)
  - (8) how well bottom plugged Capped

DRILLERS REMARKS:

**RECEIVED**  
 AUG 9 1977

If well telescopes please sketch and show depths.

GROUND LEVEL

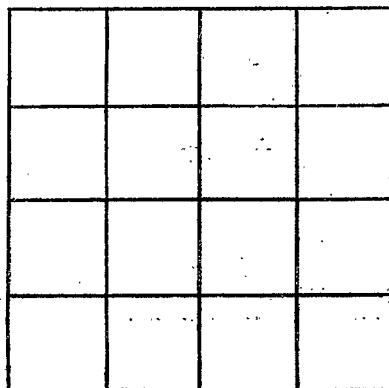

SECTION \_\_\_\_\_

Please indicate well location X.

ADDITIONAL INFORMATION

If more than one screen, show locations of each on sketch.