

MISSISSIPPI DEPARTMENT OF NATURAL RESOURCES

Bureau of Land and Water Resources

Southport Mall

P.O. Box 10631

Jackson, Mississippi 39209

WATER WELL DRILLERS LOG

Perry  
 Q 2007  
 8-25-81

8-25 1981 date well completed  
 Parnell Anderson firm name  
 Perry Stone county well located

LANDOWNER: Woodrow Brulaw  
 Rt 1 Box 91  
 Wiggins, Ms. 39547  
 (mailing address)

description of formations encountered

Top soil  
 Clay  
 Sand  
 Blue clay  
 Sand

from

to

0 2  
 2 19  
 19 36  
 36 88  
 88 102

WELL LOCATION:

sec. 36 T. 1 N R. 10 E  
 S W  
 16 miles E of Wiggins  
 (distance) (direction) (nearest town)

WELL PURPOSE: home  
 (home, irrigation, municipal, industrial)

WELL COMPLETION DATA:

- (1) diameter (inches) 2"
- (2) total depth (feet) 102'
- (3) static water level (feet) 40' below top of ground.
- (4) casing PVC 97' (material) (depth)
- (5) screen 5' 97' (length) (depth to top)  
 2" PVC (size) (material)
- (6) pump 1 9 (HP) (yield gpm)  
 Electric (type power)
- (7) electric log NO (yes or no)

(organization running log)

(8) how well bottom plugged Capped

DRILLERS REMARKS:


DEPT. OF NATURAL RESOURCES  
 BUREAU OF LAND & WATER RESOURCES

OCT - 2 1981

RECEIVED

If well telescopes please sketch and show depths.

GROUND LEVEL

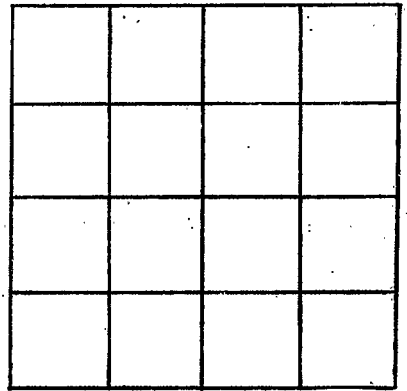

SECTION \_\_\_\_\_

Please indicate well location X.

ADDITIONAL INFORMATION

If more than one screen,  
show locations of each on sketch.