

Perry
0
2008

MISSISSIPPI
 BOARD OF WATER COMMISSIONERS
 416 North State Street
 Jackson, Mississippi 39201

WATER WELL DRILLERS LOG

Dec 9 1992 Garrett Anderson Perry
 date well completed firm name county well located

LANDOWNER: I. T. Wilson

Plt 1
Brooklyn, MS
 (mailing address)

description of formations encountered	from	to
<u>top soil</u>	<u>0</u>	<u>3</u>
<u>Clay</u>	<u>3</u>	<u>17</u>
<u>sand</u>	<u>17</u>	<u>28</u>
<u>Clay</u>	<u>28</u>	<u>36</u>
<u>sand</u>	<u>36</u>	<u>59</u>

WELL LOCATION:

sec. 10 T 1 N R 10 E
 S W
10 miles S of Meridian
 (distance) (direction) (nearest town)

WELL PURPOSE: same
 (home, irrigation, municipal, industrial)

WELL COMPLETION DATA:

- (1) diameter (inches) 2"
- (2) total depth (feet) 59'
- (3) static water level (feet) 54 below top of ground.
- (4) casing PVC (material) (depth) _____
 (size) if telescope see back.
- (5) screen 5' 49' (length) (depth to top)
2" PVC (size) (material)
- (6) pump 1 5 (HP) (yield gpm)
Electric (type power)
- (7) electric log NO (yes or no)

(organization running log)

(8) how well bottom plugged Caprock

DRILLERS REMARKS:


DEPT. OF NATURAL RESOURCES
 BUREAU OF LAND & WATER RESOURCES

FEB - 2 1983

RECEIVED

If well telescopes please sketch and show depths.

GROUND LEVEL

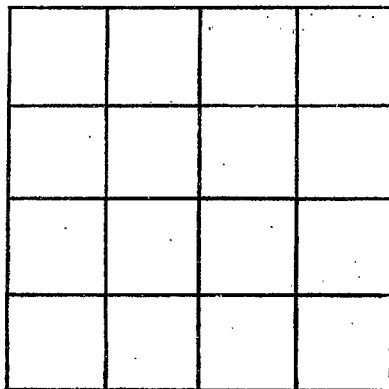

SECTION _____

Please indicate well location X.

ADDITIONAL INFORMATION

If more than one screen, show locations of each on sketch.