

Perry  
0  
2010

MISSISSIPPI  
 BOARD OF WATER COMMISSIONERS  
 416 North State Street  
 Jackson, Mississippi 39201

WATER WELL DRILLERS LOG

Sept 1 1982 Paamee Anderson Perry  
 date well completed firm name county well located

LANDOWNER: Larry Cochran  
Rt 1 Box 67 A  
Brooklyn, MS 39425  
 (mailing address)

description of formations encountered	from	to
<u>top soil</u>	<u>0</u>	<u>2</u>
<u>clay</u>	<u>2</u>	<u>24</u>
<u>sand</u>	<u>24</u>	<u>42</u>
<u>clay</u>	<u>42</u>	<u>63</u>
<u>sand</u>	<u>63</u>	<u>80</u>

WELL LOCATION:  
 sec. 11 T 1 N R 10 E  
 W  
10 miles S of New Augusta  
 (distance) (direction) (nearest town)

WELL PURPOSE: home  
 (home, irrigation, municipal, industrial)

WELL COMPLETION DATA:  
 (1) diameter (inches) 2"  
 (2) total depth (feet) 80'  
 (3) static water level (feet) 50' below top of ground.  
 (4) casing PVC (material) (depth) \_\_\_\_\_  
 \_\_\_\_\_ (size) if telescope see back.  
 (5) screen 5' 45' (length) (depth to top)  
2" PVC (size) (material)  
 (6) pump 1 11 (HP) (yield gpm)  
Electric (type power)  
 (7) electric log NO (yes or no)  
 \_\_\_\_\_ (organization running log)  
 (8) how well bottom plugged Capped

DRILLERS REMARKS: \_\_\_\_\_


DEPT. OF NATURAL RESOURCES  
 BUREAU OF LAND & WATER RESOURCES

FEB - 2 1983

RECEIVED

If well telescopes please sketch and show depths.

GROUND LEVEL

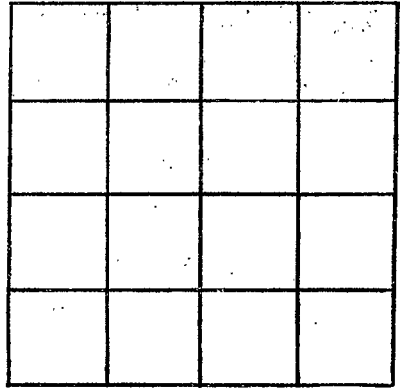

SECTION \_\_\_\_\_

Please indicate well location X.

ADDITIONAL INFORMATION

If more than one screen,  
show locations of each on sketch.