

Perry
0
2011

MISSISSIPPI DEPARTMENT OF NATURAL RESOURCES
 Bureau of Land and Water Resources
 Southport Mall
 P.O. Box 10631
 Jackson, Mississippi 39209
WATER WELL DRILLERS LOG

May 21-1982 Cochran & Bros. Drilling Serv Perry
 date well completed firm name county well located

LANDOWNER:
Wendell Penton
P.O. Box Brookland
 (mailing address)

description of formations encountered	from	to
<u>top soil</u>	<u>0</u>	<u>2</u>
<u>red clay</u>	<u>2</u>	<u>10</u>
<u>gray clay</u>	<u>10</u>	<u>29</u>
<u>band</u>	<u>29</u>	<u>32</u>

WELL LOCATION:
 sec. 29 T. 1 N. R. 10 E.
 S. W.
3 miles NE of Janice
 (distance) (direction) (nearest town)

WELL PURPOSE: home
 (home, irrigation, municipal, industrial)


- WELL COMPLETION DATA:**
- (1) diameter (inches) 2"
 - (2) total depth (feet) 82'
 - (3) static water level (feet) 30 below top of ground.
 - (4) casing PVC, 72'
 (material) (depth)
 - (5) screen 10' 72'
 (length) (depth to top)
2" PVC
 (size) (material)
 - (6) pump 1 6
 (HP) (yield gpm)
Elec
 (type power)
 - (7) electric log no
 (yes or no)
 - (8) how well bottom plugged water

DRILLERS REMARKS:

DEPT. OF NATURAL RESOURCES
 BUREAU OF LAND & WATER RESOURCES
 JUN 23 1982
RECEIVED

If well telescopes please sketch and show depths.

GROUND LEVEL

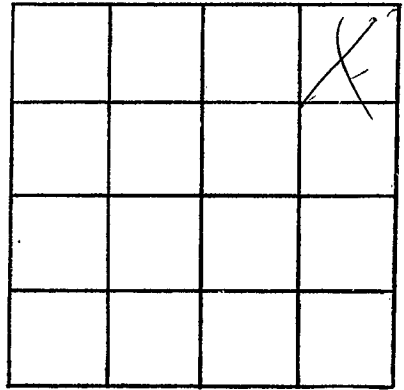

SECTION 29

Please indicate well location X.

ADDITIONAL INFORMATION

If more than one screen,
show locations of each on sketch.