

MISSISSIPPI DEPARTMENT OF ENVIRONMENTAL QUALITY

Office of Land and Water Resources

P. O. Box 10631
Jackson, MS 39289-0631
WATER WELL DRILLERS LOG

COUNTY WELL LOCATED <i>Perry</i>	
WELL NUMBER <i>13</i>	CODED
DATE WELL COMPLETED <i>3-22-95</i>	

PERMIT NUMBER
NAME OF DRILLING FIRM <i>Boone's Water Well</i>

NAME & MAILING ADDRESS OF LANDOWNER <i>Wallace Reyer</i> <i>56 Bendale Rd</i> <i>Jamice</i>			
WELL LOCATION:	SEC	TOWNSHIP	RANGE
	<i>26</i>	<i>1</i>	<i>N 10 E</i>
DISTANCE	DIRECTION	NEAREST TOWN	
<i>4</i> Miles	<i>E</i>	of <i>Jamice</i>	
OTHER LANDMARK			
WELL PURPOSE: <input checked="" type="checkbox"/> Home Irrigation, <input type="checkbox"/> Municipal, <input type="checkbox"/> Industrial, <input type="checkbox"/> Fish Pond, etc.			

PUMP DATA		
PUMP TYPE (Circle One): Submersible, Turbine, <input checked="" type="radio"/> Jet, Flowing Well, Other (Describe)		
POWER TYPE (Circle One): <input checked="" type="radio"/> Electric, Tractor, Diesel, Gasoline, Butane, Other (Describe) H/P <i>1</i>		
Pump Capacity (GPM)	No. of Stages	Setting Depth FT.
PUMP TEST		
Well yielded _____ GPM with a drawdown of _____ ft. after _____ hours of pumping		

WELL DATA		
Well Depth <i>90</i>	Casing Diameter (In.) <i>2</i>	Casing Length (Ft.) <i>80</i>
Type of Casing <i>nch 40</i>	Hole Depth <i>90</i>	Depth to Static Water Level <i>35</i>

TYPE OF COMPLETION: (Circle One or More):
 Gravel Packed, Underreamed, Telescoped,
 Natural Development, Open Hole, Other

WELL GROUTED TO A DEPTH OF *5* FEET
 Type Grout (circle one): Cement, Bentonite, or Mix

SCREEN DATA		
Diameter - Inches <i>2</i>	Length - Feet <i>10</i>	Slot Size - Inches <i>8</i>
Screen Type <i>nch 40</i>		Depth to Bottom - Feet

LOG DATA	
TYPE OF LOG RUN (Circle One): No Log Run, Electric, Gamma Ray, Density, Sonic, Neutron, Other (Describe)	
Name of Organization Running Log	

GEOLOGIC DATA (Office Use Only)			
Surface Elev.	Geologic Unit	Unit Thickness	Depth to Top
Subs. SWL	Date	Analysis	Aquifer Test
Driller's Remarks			
Top of Lap Pipe or Reduction in Casing			
FEET IF TELESCOPED OR MORE THAN ONE SCREEN: USE BACK PAGE			

DESCRIPTION OF FORMATIONS ENCOUNTERED	FROM	TO	FORMATIONS (Continued)	
			FROM	TO
<i>Clay</i>	<i>0</i>	<i>30</i>		
<i>Sand</i>	<i>30</i>	<i>90</i>		

RECEIVED


JUN 12 1995

Dept. of Environmental Quality
Office of Land & Water Resources

IF MORE SPACE IS NEEDED, USE BACK

If well telescopes please
sketch and show depths.

GROUND LEVEL

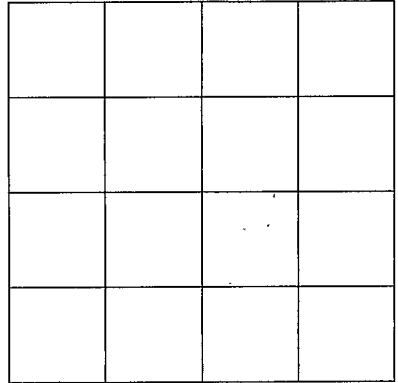

SECTION _____

Please indicate well location X.

ADDITIONAL INFORMATION

If more than one screen,
show location of each on sketch.