

PERRY
 2015
 5-2-79

MISSISSIPPI
 BOARD OF WATER COMMISSIONERS
 416 North State Street
 Jackson, Mississippi 39201

WATER WELL DRILLERS LOG

5-2
 date well completed

1979 Arnold Anderson
 firm name

Perry
 county well located

LANDOWNER:	description of formations encountered	from	to
<u>Thomas Wilson</u>	<u>Top Soil</u>	<u>0</u>	<u>2</u>
(mailing address)	<u>Standy Clay</u>	<u>2</u>	<u>34</u>
WELL LOCATION:	<u>Course & Road</u>	<u>24</u>	<u>67</u>
sec. <u>18</u> T. <u>2</u> S. R. <u>10</u> E. W. <u>5</u>			
<u>5</u> miles <u>N</u> of <u>Jarvis</u>			
(distance) (direction) (nearest town)			
WELL PURPOSE: <u>HOME</u> (home, irrigation, municipal, industrial)			
WELL COMPLETION DATA:			
(1) diameter (inches) <u>2"</u>			
(2) total depth (feet) <u>67</u>			
(3) static water level (feet) <u>4</u> below top of ground.			
(4) casing <u>Plastic</u> , <u>64'</u> (material) (depth)			
(size) If telescope see back.			
(5) screen <u>3'</u> , <u>64'</u> (length) (depth to top)			
<u>2"</u> , <u>Plastic</u> (size) (material)			
(6) pump <u>1</u> , <u>8</u> (HP) (yield gpm)			
<u>Elect</u> (type power)			
(7) electric log <u>no</u> (yes or no)			
(organization running log)			
(8) how well bottom plugged <u>Cap</u>			
DRILLERS REMARKS:			


Miss. Board of Water Comm.

JUN - 8 1979

RECEIVED

If well telescopes please sketch and show depths.

GROUND LEVEL

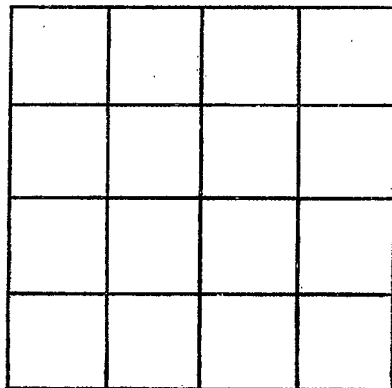

SECTION _____

Please indicate well location X.

ADDITIONAL INFORMATION

If more than one screen, show locations of each on sketch.