

MISSISSIPPI DEPARTMENT OF ENVIRONMENTAL QUALITY

Office of Land and Water Resources

COUNTY WELL LOCATED Perry	
WELL NUMBER 2016	CODED
DATE WELL COMPLETED 1-22-2000	

PERMIT NUMBER
NAME OF DRILLING FIRM Moore's Water Well Service
31 R. Moore Rd

P. O. Box 10631
Jackson, MS 39289-0631
WATER WELL DRILLERS LOG

NAME & MAILING ADDRESS OF LANDOWNER Deborah Cruise 90 Bellanger Rd. Janice, MS			
WELL LOCATION:	SEC 23	TOWNSHIP 1	RANGE N 10 W
DISTANCE 7 Miles	DIRECTION NE	NEAREST TOWN Janice	
OTHER LANDMARK			
WELL PURPOSE: <input checked="" type="checkbox"/> Home, <input type="checkbox"/> Irrigation, <input type="checkbox"/> Municipal, <input type="checkbox"/> Industrial, <input type="checkbox"/> Fish Pond, etc.			

PUMP DATA		
PUMP TYPE (Circle One): Submersible, Turbine, <input checked="" type="radio"/> Jet Flowing Well, Other (Describe) _____		
POWER TYPE (Circle One): <input checked="" type="radio"/> Electric , Tractor, Diesel, Gasoline, Butane, Other (Describe) _____ H/P _____		
Pump Capacity (GPM) 4	No. of Stages 2	Setting Depth FT.
PUMP TEST		
Well yielded _____ GPM with a drawdown of _____ ft. after _____ hours of pumping		

WELL DATA		
Well Depth 130'	Casing Diameter (In.) 2"	Casing Length (Ft.) 110'
Type of Casing PVC	Hole Depth 130'	Depth to Static Water Level 95'

LOG DATA	
TYPE OF LOG RUN (Circle One): No Log Run, Electric, Gamma Ray, Density, Sonic, Neutron, Other (Describe) _____	
Name of Organization Running Log	

TYPE OF COMPLETION: (Circle One or More):
 Gravel Packed, Underreamed, Telescoped,
 Natural Development, Open Hole, Other
 (Describe) _____

GEOLOGIC DATA (Office Use Only)			
Surface Elev.	Geologic Unit	Unit Thickness	Depth to Top
Subs. SWL	Date	Analysis	Aquifer Test
Driller's Remarks			
Top of Lap Pipe or Reduction in Casing			
FEET		IF TELESCOPED OR MORE THAN ONE SCREEN: USE BACK PAGE	

WELL GROUTED TO A DEPTH OF **10** FEET
 Type Grout (circle one): Cement, Bentonite, or Mix

SCREEN DATA		
Diameter - Inches 2"	Length - Feet 20'	Slot Size - Inches .08'
Screen Type PVC sch 40	Depth to Bottom - Feet 130'	


DESCRIPTION OF FORMATIONS ENCOUNTERED	FROM	TO
top soil	1'	2'
red sandy clay	2'	10'
red sand	10'	20'
red soapstone	20'	30'
red coarse sand	30'	42'
white soapstone	42'	58'
white coarse sand	58'	62'
white + Brown soapstone	62'	85'
fine + coarse sand	85'	100'
sand + white soapstone	100'	115'
coarse white sand	115'	130'

FORMATIONS (Continued)	FROM	TO

IF MORE SPACE IS NEEDED, USE BACK

If well telescopes please
sketch and show depths.

GROUND LEVEL

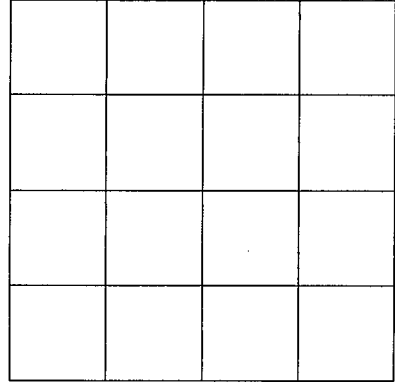

SECTION _____

Please indicate well location X.

ADDITIONAL INFORMATION

If more than one screen,
show location of each on sketch.