

Perry
P3
9-27-72

MISSISSIPPI  
 BOARD OF WATER COMMISSIONERS  
 416 North State Street  
 Jackson, Mississippi 39201

WATER WELL DRILLERS LOG

**CODED**

September 27, 1972 Cochran Drilling Service Perry  
 date well completed firm name county well located

LANDOWNER:  
 Johnnie Cobb  
 Rt. 2 Mc Jain  
 (mailing address)

description of formations encountered	from	to
Top Soil	0	2
red sand	2	9
Brown clay	9	18
gray clay	18	29
blue clay	29	41
sand	41	65

WELL LOCATION:  
 sec. 2-T-1 N R-9-E  
 S W  
 8 miles SW of Mc Jain  
 (distance) (direction) (nearest town)

WELL PURPOSE:  
 (home, irrigation, municipal, industrial)

WELL COMPLETION DATA:

(1) diameter (inches) 2"

(2) total depth (feet) 65'

(3) static water level (feet) 38' below above top of ground.

(4) casing PVC, 60', (material) (depth)  
 (size) If telescope see back.

(5) screen 5', 60' (length) (depth to top)  
 2" PVC (size) (material)

(6) pump 1 (HP) 2 (yield gpm)  
 Electric (type power)

(7) electric log no (yes or no)  
 (organization running log)

(8) how well bottom plugged valve

**CODED**


OCT - 8 1972

MISS. BD. OF  
 WATER COMMISSIONERS

DRILLERS REMARKS:

If well telescopes please sketch and show depths.

GROUND LEVEL

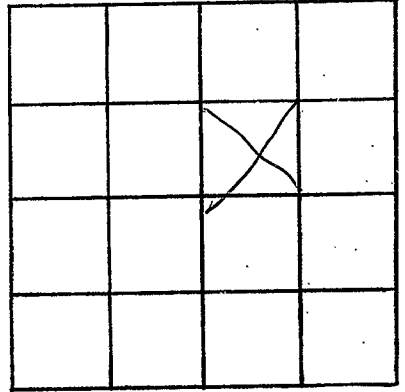

SECTION 2

Please indicate well location X.

ADDITIONAL INFORMATION

If more than one screen,  
show locations of each on sketch.