

MISSISSIPPI  
BOARD OF WATER COMMISSIONERS  
416 North State Street  
Jackson, Mississippi 39201

**CODED**

WATER WELL DRILLERS LOG

PERRY  
P4  
11-3-72

Nov 3 1972 Cochran Drilling Ser Perry  
date well completed firm name county well located

LANDOWNER: Danny Clifton  
Rt Perry County  
(mailing address)

description of formations encountered	from	to
Top Soil	0	2
red clay	2	18
Brown clay	18	23
gray clay	23	31
blue clay	31	62
sand	62	80

WELL LOCATION:  
sec. 1 T. 1 N. R. 9 E  
4 miles SW of Mablin  
(distance) (direction) (nearest town)

WELL PURPOSE: home  
(home, irrigation, municipal, industrial)

- WELL COMPLETION DATA:
- (1) diameter (inches) 2"
  - (2) total depth (feet) 80
  - (3) static water level (feet) 41 below above top of ground.
  - (4) casing PVC, 75'  
(material) (depth)  
\_\_\_\_ (size) If telescope see back.
  - (5) screen 5', 75'  
(length) (depth to top)  
2", PVC  
(size) (material)
  - (6) pump 1, 5  
(HP) (yield gpm)  
Electric  
(type power)
  - (7) electric log no  
(yes or no)  
\_\_\_\_ (organization running log)
  - (8) how well bottom plugged valve


**CODED**

DRILLERS REMARKS:

FEB 9 1973

If well telescopes please sketch and show depths.

GROUND LEVEL

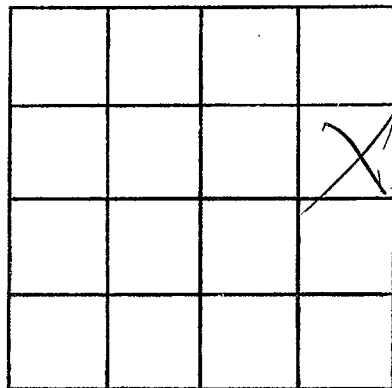

SECTION 1

Please indicate well location X.

ADDITIONAL INFORMATION

If more than one screen,  
show locations of each on sketch.