

PERRY
 P 5
 1-8-74

MISSISSIPPI
 BOARD OF WATER COMMISSIONERS
 416 North State Street
 Jackson, Mississippi 39201

WATER WELL DRILLERS LOG


Jan 8 - 1974 date well completed
 24 Cochran Drilling, Inc. firm name
 Perry county well located

LANDOWNER:
 W. Cawart
 (mailing address)
 WELL LOCATION:
 sec. 9 T 1 N R 9 E
 (distance) miles (direction) of (nearest town)

description of formations encountered	from	to
top soil	0	3
red sand	3	9
red clay	9	14
bragg clay	14	44
gray clay	44	87
blue clay	87	112
sand	112	118
blue clay	118	180
sand	180	220

WELL PURPOSE: home
 (home, irrigation, municipal, industrial)

WELL COMPLETION DATA:
 (1) diameter (inches) 2"
 (2) total depth (feet) 220 feet
 (3) static water level (feet) 12' below top of ground
 (4) casing PVC, 210' (material) (depth)
 2" (size) if telescope see back.
 (5) screen 10', 210' (length) (depth to top)
 2" PVC (size) (material)
 (6) pump 1 1/2 HP, 5 (yield gpm)
 Elect (type power)
 (7) electric log no (yes or no)
 (organization running log)
 (8) how well bottom plugged valve

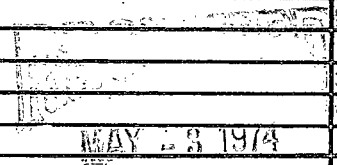


MAY 23 1974

DRILLERS REMARKS:

MISS. BD. OF WATER COMMISSIONERS

If well telescopes please sketch and show depths.

GROUND LEVEL

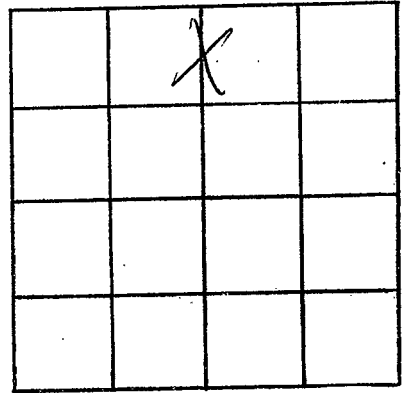

SECTION 9

Please indicate well location X.

ADDITIONAL INFORMATION

If more than one screen, show locations of each on sketch.