

Was first # 52

CODED

MISSISSIPPI  
BOARD OF WATER COMMISSIONERS  
416 North State Street  
Jackson, Mississippi 39201

WATER WELL DRILLERS LOG

Perry
<del>Perry</del> 2000
6-25-69
6-25

date well completed

1969 Lew Smith

firm name

Perry

county well located

LANDOWNER:	description of formations encountered	from	to
Jerry Woods McLean (mailing address)			
WELL LOCATION:			
sec. 2 T. 1 N. R. 9 W.			
(distance) miles (direction) of (nearest town)			
WELL PURPOSE: (home, irrigation, municipal, industrial)			
WELL COMPLETION DATA:			
(1) diameter (inches) 2"			
(2) total depth (feet) 85			
(3) static water level (feet) 51 below above top of ground.			
(4) casing Plastic (material) (depth)			
(size) if telescope see back.			
(5) screen 5' 80 (length) (depth to top)			
(size) (material)			
(6) pump 1 14 (HP) (yield gpm)			
(type power)			
(7) electric log (yes or no)			
(organization running log)			
(8) how well bottom plugged B.W.			


JUL 30 1969

MISS. BD. OF  
WATER COMM.

DRILLERS REMARKS:

If well telescopes please sketch and show depths.

GROUND LEVEL

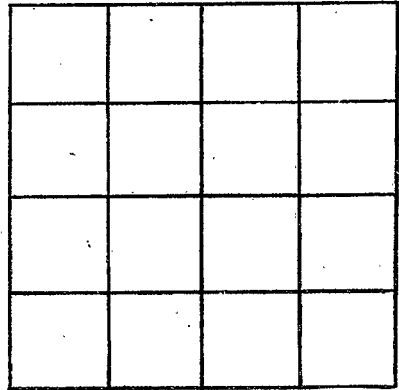

SECTION \_\_\_\_\_

Please indicate well location X.

ADDITIONAL INFORMATION

If more than one screen,  
show locations of each on sketch.