

Perry
 P 2001
 4-21-80

MISSISSIPPI
 BOARD OF WATER COMMISSIONERS
 416 North State Street
 Jackson, Mississippi 39201

WATER WELL DRILLERS LOG

4-21-80¹⁹ FryFogle Well Service Perry
 date well completed firm name county well located

LANDOWNER: Jerry Baltas	description of formations encountered	from	to
McLain, MS (mailing address)	Dirt	0	6
	Sand	6	20
	Sand & gravel	20	38
	Blue Clay	40	45
	Sand	45	52
	Blue Clay	52	90
	fine Blue Sand	90	120

WELL LOCATION: ?
 sec 24 T 18 N R 9 E
 8 8 miles SE of Bogalusa
 (distance) (direction) (nearest town)

WELL PURPOSE:
 (home) irrigation, municipal, industrial

WELL COMPLETION DATA: 4-21-80

- (1) diameter (inches) 2"
- (2) total depth (feet) 120'
- (3) static water level (feet) 18' ^{below} top of ground
- (4) casing PVC, 110' (material) (depth)
 (size) If telescope see back.
- (5) screen 10', 110' (length) (depth to top)
 2" PVC (size) (material)
- (6) pump 3/4 (HP) 10 (yield gpm)
 5/8 (type power)
- (7) electric log (yes or no) (no)

(organization running log)

(8) how well bottom plugged 2" PVC
 Backwash Valve

DRILLERS REMARKS:


STATE OF MISSISSIPPI
 BUREAU OF LAND & WATER RESOURCES

AUG 15 1980

RECEIVED

If well telescopes please sketch and show depths.

GROUND LEVEL

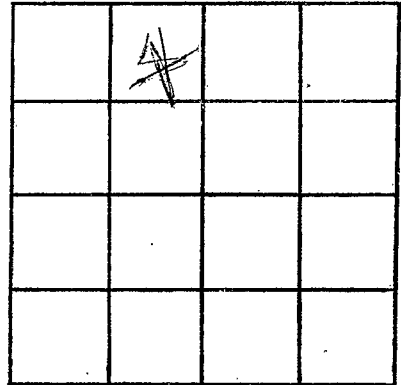

SECTION 24

Please indicate well location X.

ADDITIONAL INFORMATION

If more than one screen,
show locations of each on sketch.