

Perry
 Q3
 2-68

MISSISSIPPI
 BOARD OF WATER COMMISSIONERS
 416 North State Street
 Jackson, Mississippi 39201

CODED

WATER WELL DRILLERS LOG

2-26 1968 L.W. Smith Perry
 date well completed firm name county well located

LANDOWNER: J. S. Branch
Wiggins R.
 (mailing address)


description of formations encountered	from	to
Sand	0	2
Clay	2	12
Sand	12	70
Clay	70	

WELL LOCATION:
 sec 28 T. 10 S. R. 11 W.
6 miles NE of Wiggins
 (distance) (direction) (nearest town)

WELL PURPOSE: Home + stock
 (home, irrigation, municipal, industrial)


- WELL COMPLETION DATA:
- diameter (inches) _____
 - total depth (feet) 70
 - static water level (feet) 50 below/above top of ground.
 - casing Plastic 65 (material), (depth)
 _____ if telescope see back. (size)
 - screen 5' (length), 65' (depth to top)
 _____ (size), _____ (material)
 - pump 1 (HP), 6 (yield gpm)
Electric (type power)
 - electric log _____ (yes or no)
 _____ (organization running log)
 - how well bottom plugged Backside

DRILLERS REMARKS:

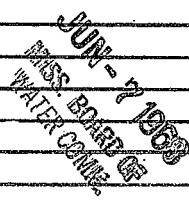

If well telescopes please sketch and show depths.

GROUND LEVEL

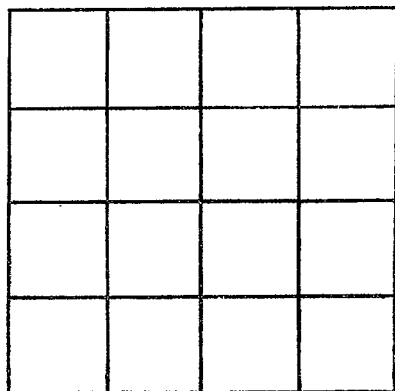

SECTION _____

Please indicate well location X.

ADDITIONAL INFORMATION

If more than one screen, show locations of each on sketch.