

Perry  
 Q5  
 3-67

MISSISSIPPI  
 BOARD OF WATER COMMISSIONERS  
 416 North State Street  
 Jackson, Mississippi 39201

CODED

WATER WELL DRILLERS LOG

3-3 1967 L W Smith Perry  
 date well completed firm name county well located

LANDOWNER:

Victor Blair  
 Wiggins Route 1  
 (mailing address)

description of formations encountered

from to

Top Soil	0	1
Clay	1	20
Fine Sand	20	60
Coarse Sand	60	85

WELL LOCATION:

sec 29 T. 1 N. R. 11 W. S. 3  
 7 miles N.E. of Wiggins  
 (distance) (direction) (nearest town)


WELL PURPOSE:

(home, irrigation, municipal, industrial)

WELL COMPLETION DATA:


- (1) diameter (inches) 2"
- (2) total depth (feet) 85'
- (3) static water level (feet) 49' below above top of ground.
- (4) casing Plastic  
 (material) (depth)  
 If telescope see back.  
 (size)
- (5) screen 5'  
 (length) (depth to top)  
2" Plastic  
 (size) (material)
- (6) pump \_\_\_\_\_ (HP) \_\_\_\_\_ (yield gpm)  
Electric  
 (type power)
- (7) electric log no  
 (yes or no)  
 (organization running log)
- (8) how well bottom plugged  
Backward

DRILLERS REMARKS:

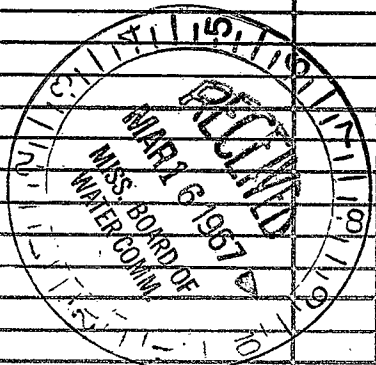

If well telescopes please sketch and show depths.

GROUND LEVEL

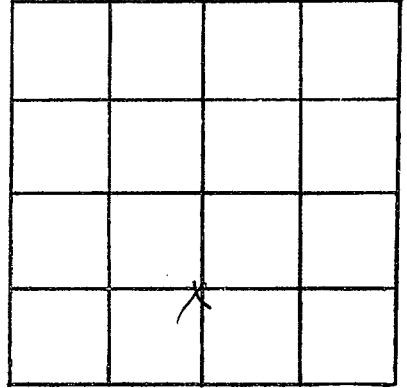

SECTION 29

Please indicate well location X.

ADDITIONAL INFORMATION

If more than one screen, show locations of each on sketch.