

Perry  
 Q 6  
 6-30-68

MISSISSIPPI  
 BOARD OF WATER COMMISSIONERS  
 416 North State Street  
 Jackson, Mississippi 39201

CODED

CODED

CODED

WATER WELL DRILLERS LOG

6-30 1968 L W Smith Perry  
 date well completed firm name county well located

LANDOWNER:  
 Frank Lee  
 Wiggins R.  
 (mailing address)

description of formations encountered from to

WELL LOCATION:  
 sec. 36 T 1 S R 11 W  
 7 miles E of Wiggins  
 (distance) (direction) (nearest town)

WELL PURPOSE:  
 (home, irrigation, municipal, industrial)

WELL COMPLETION DATA:

(1) diameter (inches) 2  
 (2) total depth (feet) 87  
 (3) static water level (feet) 40 below above top of ground.  
 (4) casing Plastic (material), (depth),  
 (size) If telescope see back.  
 (5) screen 5 80 (length) (depth to top)  
 (size) (material)  
 (6) pump 1 12 (HP) (yield gpm)  
 Electric (type power)  
 (7) electric log (yes or no)  
 (organization running log)  
 (8) how well bottom plugged Bachler

RECORDED


FEB - 4 1969

MISS. BD. OF WATER COM.

DRILLERS REMARKS:

If well telescopes please sketch and show depths.

GROUND LEVEL

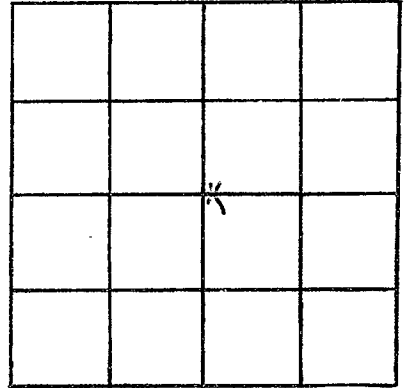

SECTION 36

Please indicate well location X.

ADDITIONAL INFORMATION

If more than one screen, show locations of each on sketch.