

CODED

MISSISSIPPI  
BOARD OF WATER COMMISSIONERS  
416 North State Street  
Jackson, Mississippi 39201

CODED

WATER WELL DRILLERS LOG

Perry  
Q 7  
1-28-69

1-28 1969  
date well completed

L. W. Smith  
firm name

Perry  
county well located

LANDOWNER:

James Walters  
Wiggins  
(mailing address)

description of formations encountered

Top 8'  
Clay  
Sand  
Clay

from	to
0	1
1	14
14	52

WELL LOCATION:

sec. 27 T 1 S R 11 W  
7 miles N.E. of Wiggins  
(distance) (direction) (nearest town)

CODED

WELL PURPOSE:

(home, irrigation, municipal, industrial)

WELL COMPLETION DATA:

- (1) diameter (inches) 2"
- (2) total depth (feet) 52'
- (3) static water level (feet) 34' below top of ground.
- (4) casing Plastic 52' (material) (depth)
- \_\_\_\_\_ If telescope see back. (size)
- (5) screen 5' 47' (length) (depth to top)  
2" Plastic (size) (material)
- (6) pump 1 14 (HP) (yield gpm)  
Electric (type power)
- (7) electric log \_\_\_\_\_ (yes or no)  
\_\_\_\_\_ (organization running log)
- (8) how well bottom plugged B.W.

CODED


FEB - 4 1969

MISS. BD. OF  
WATER COM.

DRILLERS REMARKS:

If well telescopes please sketch and show depths.

GROUND LEVEL

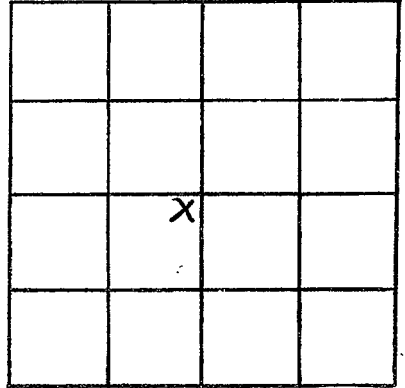

SECTION 27

Please indicate well location X.

ADDITIONAL INFORMATION

If more than one screen, show locations of each on sketch.