

PERRY

Q 12

6-30-70

MISSISSIPPI BOARD OF WATER COMMISSIONERS  
416 North State Street  
Jackson, Mississippi 39201

**CODED**

WATER WELL DRILLERS LOG

6-30

19 20 Parrell Anderson Perry

county well located

LANDOWNER:

J. W. Hart

Wiggins  
WJ

(mailing address)

description of formations encountered

from to

Top Soil  
Red Clay  
Fine Sand  
Red Clay  
Fine Sand  
Coarse Sand

0 3  
3 18  
18 24  
24 39  
39 44  
44 58

WELL LOCATION:

sec 27 T 1 N R 11 E S W  
8 miles N of Wiggins  
(distance) (direction) (nearest town)

WELL PURPOSE:

Home (home, irrigation, municipal, industrial)

WELL COMPLETION DATA:

- (1) diameter (inches) 2
- (2) total depth (feet) 58
- (3) static water level (feet) 30 below top of ground above
- (4) casing Plastic 52 (material) (depth)  
(size) if telescope see back.
- (5) screen 6' 52 (length) (depth to top)  
2" Plastic (size) (material)
- (6) pump 1 8 (HP) (yield gpm)  
Elect (type power)
- (7) electric log (yes or no)
- (organization running log)
- (8) how well bottom plugged  
Bechtel Valve

**CODED**


JUN 11 1971  
JUN 11 1971

DRILLERS REMARKS:

MES. ED. OF  
WATER COMM.

If well telescopes please sketch and show depths.

GROUND LEVEL

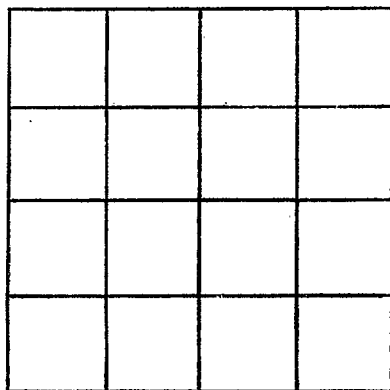

SECTION \_\_\_\_\_

Please indicate well location X.

ADDITIONAL INFORMATION

If more than one screen,  
show locations of each on sketch.