

PERRY
Q13
7-6-70

MISSISSIPPI
 BOARD OF WATER COMMISSIONERS
 416 North State Street
 Jackson, Mississippi 39201

CODED

WATER WELL DRILLERS LOG

7-6 date well completed 1970 Parnell Anderson firm name Perry county well located

LANDOWNER: Cross Roads Church, Wiggins
 (mailing address)

description of formations encountered	from	to
TOP SOIL	0	3
Red Clay	3	28
Fine SLEWD	28	36
Red Clay	36	78
Fine Sand	78	91
CORSE SAND	91	105

WELL LOCATION:
 sec. 30 T. 1 S. R. 11 W.
6 miles N of Wiggins
 (distance) (direction) (nearest town)

WELL PURPOSE:
 (home, irrigation, municipal, industrial)

- WELL COMPLETION DATA:
- (1) diameter (inches) 2
 - (2) total depth (feet) 105
 - (3) static water level (feet) 60 below top of ground.
 - (4) casing Plastic (material) 99 (depth)
 - (size) if telescope see back.
 - (5) screen 6 (length) 99 (depth to top)
 - 2" (size) Plastic (material)
 - (6) pump 1 (HP) 9 (yield gpm)
 - Elet (type power)
 - (7) electric log (yes or no)
 - (organization running log)
 - (8) how well bottom plugged Backwash Valve

CODED


JUN 11 1971

DRILLERS REMARKS:

MISS. BD. OF
 WATER COMMISSIONERS

If well telescopes please sketch and show depths.

GROUND LEVEL

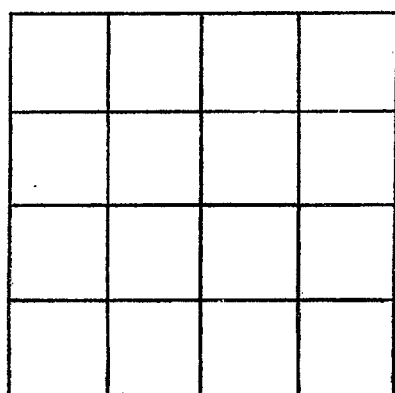

SECTION _____

Please indicate well location X.

ADDITIONAL INFORMATION

A series of horizontal lines for recording additional information, starting below the 'ADDITIONAL INFORMATION' header and extending to the bottom of the page.

If more than one screen, show locations of each on sketch.