

PERRY
Q 15
4-13-72

MISSISSIPPI
BOARD OF WATER COMMISSIONERS
416 North State Street
Jackson, Mississippi 39201

CODED

WATER WELL DRILLERS LOG

4-13 1972 Parwell Anderson Perry
date well completed firm name county well located

LANDOWNER: Reed Hunt

(mailing address)

description of formations encountered	from	to
Top Soil	0	6
Red clay	6	27
Red fine-sand	27	34
Red Clay	34	48
Coarse Sand	48	62

WELL LOCATION:
sec 27 T 1 S R 11 W
10 miles N-E of Wiggins
(distance) (direction) (nearest town)

WELL PURPOSE: Farm - Chicken
(home, irrigation, municipal, industrial)

- WELL COMPLETION DATA:
- (1) diameter (inches) 2
 - (2) total depth (feet) 62
 - (3) static water level (feet) 35 below above top of ground.
 - (4) casing Plastic, 57 (material) (depth)
 - (size) If telescope see back.
 - (5) screen 5 57 (length) (depth to top)
 - 2" Plastic (size) (material)
 - (6) pump 1 12 (HP) (yield gpm)
 - Elect (type power)
 - (7) electric log (yes or no)
 - (organization running log)
 - (8) how well bottom plugged Back was valve


CODED

MAY 25 1972

DRILLERS REMARKS:

If well telescopes please sketch and show depths.

GROUND LEVEL

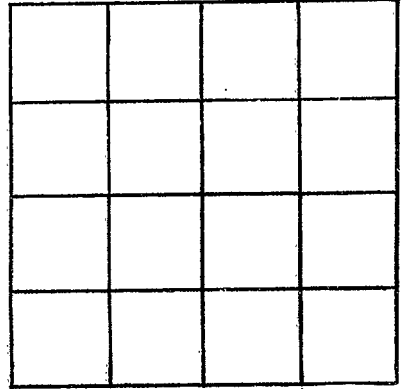

SECTION _____

Please indicate well location X.

ADDITIONAL INFORMATION

If more than one screen, show locations of each on sketch.