

PERRY
~~STONE~~
 Q 16
 7-24-73

MISSISSIPPI
 BOARD OF WATER COMMISSIONERS
 416 North State Street
 Jackson, Mississippi 39201

CODED

WATER WELL DRILLERS LOG

Perry
Anderson

7-24 19 *3* *Dannell Anderson* *Perry*
 date well completed firm name county well located

LANDOWNER:
Mark Walters
 (mailing address)

description of formations encountered	from	to
<i>Top Soil</i>	<i>0</i>	<i>4</i>
<i>Fine sand</i>	<i>4</i>	<i>16</i>
<i>Coarse Sand</i>	<i>16</i>	<i>35</i>

WELL LOCATION:
 sec. *87* T. *1* S. R. *11* W.
16 miles *NE* of *W. lag*
 (distance) (direction) (nearest town)

WELL PURPOSE: *HOME*
 (home, irrigation, municipal, industrial)

- WELL COMPLETION DATA:
- (1) diameter (inches) *2"*
 - (2) total depth (feet) *35'*
 - (3) static water level (feet) *20'* below above top of ground.
 - (4) casing *Plastic*, *32'*
 (material) (depth)
 _____ if telescope see back.
 (size)
 - (5) screen *3'*, *32'*
 (length) (depth to top)
2", *Plastic*
 (size) (material)
 - (6) pump *1/2*, *5*
 (HP) (yield gpm)
Elect
 (type power)
 - (7) electric log *no*
 (yes or no)

 (organization running log)
 - (8) how well bottom plugged
Back wash valve


CODED

DRILLERS REMARKS:

NOV 5 1973

If well telescopes please sketch and show depths.

GROUND LEVEL

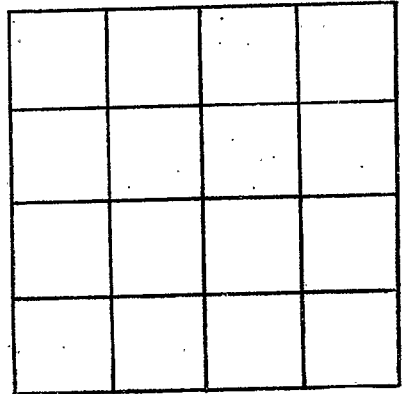

SECTION _____

Please indicate well location X.

ADDITIONAL INFORMATION

Lined area for providing additional information.

If more than one screen, show locations of each on sketch.