

PERRY

~~STORE~~

Q 17

6-25-73

MISSISSIPPI
 BOARD OF WATER COMMISSIONERS
 416 North State Street
 Jackson, Mississippi 39201

CODED PERRY

WATER WELL DRILLERS LOG

6-25-1973
date well completed

Darnell Anderson
firm name

Stamps
county well located

LANDOWNER:

Melvin Morgan
Wiggins, MS
(mailing address)

description of formations encountered

from to

Top Soil	0	6
Red Clay	6	25
Fine Sand	28	30
Coarse Sand	30	67

WELL LOCATION:

sec. 20 T. 1 S. R. 11 E. W. 18 miles N of Wiggins (distance) (direction) (nearest town)

WELL PURPOSE: HOME (home, irrigation, municipal, industrial)

WELL COMPLETION DATA:

- (1) diameter (inches) 8"
- (2) total depth (feet) 67'
- (3) static water level (feet) 45' below top of ground
- (4) casing Plastic, 62' (material) (depth)

FINED

if telescope see back. (size)

- (5) screen 5' length, 62' depth to top, 2" size, Plastic material

- (6) pump 1 HP, 7 yield gpm

Electricity (type power)

- (7) electric log no (yes or no)

(organization running log)


- (8) how well bottom plugged Rockwell valve

DRILLERS REMARKS:

NOV 5 1973

If well telescopes please sketch and show depths.

GROUND LEVEL

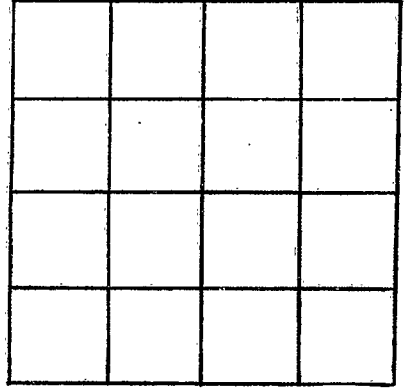

SECTION _____

Please indicate well location X.

ADDITIONAL INFORMATION

If more than one screen, show locations of each on sketch.